


RECEIVED


MAY 27 2003

WATER RESOURCES DEPT.
SALEM, OREGON

T 28 S, R 33 E, WM

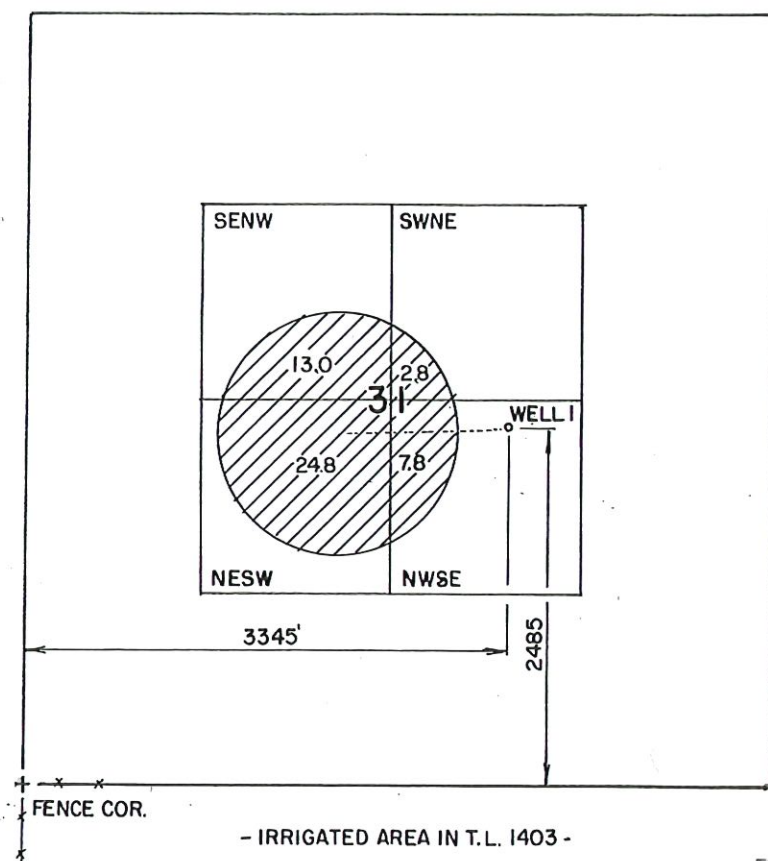

THE PURPOSE OF THIS MAP IS TO
IDENTIFY THE LOCATION OF THE
WATER RIGHT. IT IS NOT INTENDED
TO PROVIDE INFORMATION RELATIVE
TO THE LOCATION OF PROPERTY
OWNERSHIP.

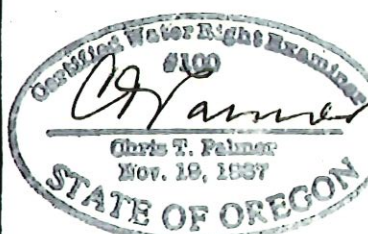

RENEW 1-1-2005

FINAL PROOF SURVEY

UNDER
APPLICATION G-13801
PERMIT G-12639

IN THE NAME OF
ROARING SPRINGS
RANCH, INC

Scale: 4" = 1 MILE	Date: APRIL 2003	Job: 1440-03
Dgn:	 M. A. PALMER & SONS, INC. ENGINEERING & SURVEYING 254 N. Alder - Box 61 Burns, Oregon 97720	Sht. No.
Drn: CHRIS		of 1
Ckd:		