







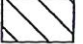
 


# T. 5 S., R.5 W., W.M.

Location: The NE 1/4, SE 1/4, NW 1/4 & SW 1/4 of the NE 1/4 and The NE 1/4, NW 1/4 & SW 1/4 of the SE 1/4 and the NE 1/4, SE 1/4, NW 1/4 & SW 1/4 of the SW 1/4 and The NE 1/4, SE 1/4 & SW 1/4 of the NW 1/4 of Section 9, The SW 1/4 of the NW 1/4 and The NW 1/4 of the SW 1/4 of Section 10, The SE 1/4 of the SE 1/4 of Section 4, The NW 1/4 of the NW 1/4 of Section 16, T. 5 S., R.5 W., W.M., Yamhill County, OR

Note: This map is not intended to provide legal dimensions or locations of property ownership lines.

## LEGEND:

-  = Tax Lot Line
-  = Property line
-  = D.L.C. line
-  = Section line
-  = "40" line
-  = Irrigation Mainlines, 4", 3" & 2" PVC, HDPE
-  = Unnamed Intermittent Stream
-  = Surface Water Appl. S-84126, Primary
-  = Ground Water Appl. G-15085, Supplemental
-  = Ground Water Appl. G-15085, Primary

Surface water sources  
unnamed tributaries of the  
South Yamhill River

**RECEIVED**

SEP 07 2016

WATER RESOURCES DEPT  
SALEM, OREGON Scale: 1" = 660'

## CLAIMS OF BENEFICIAL USE MAP

UNDER

S-84126

S-53672

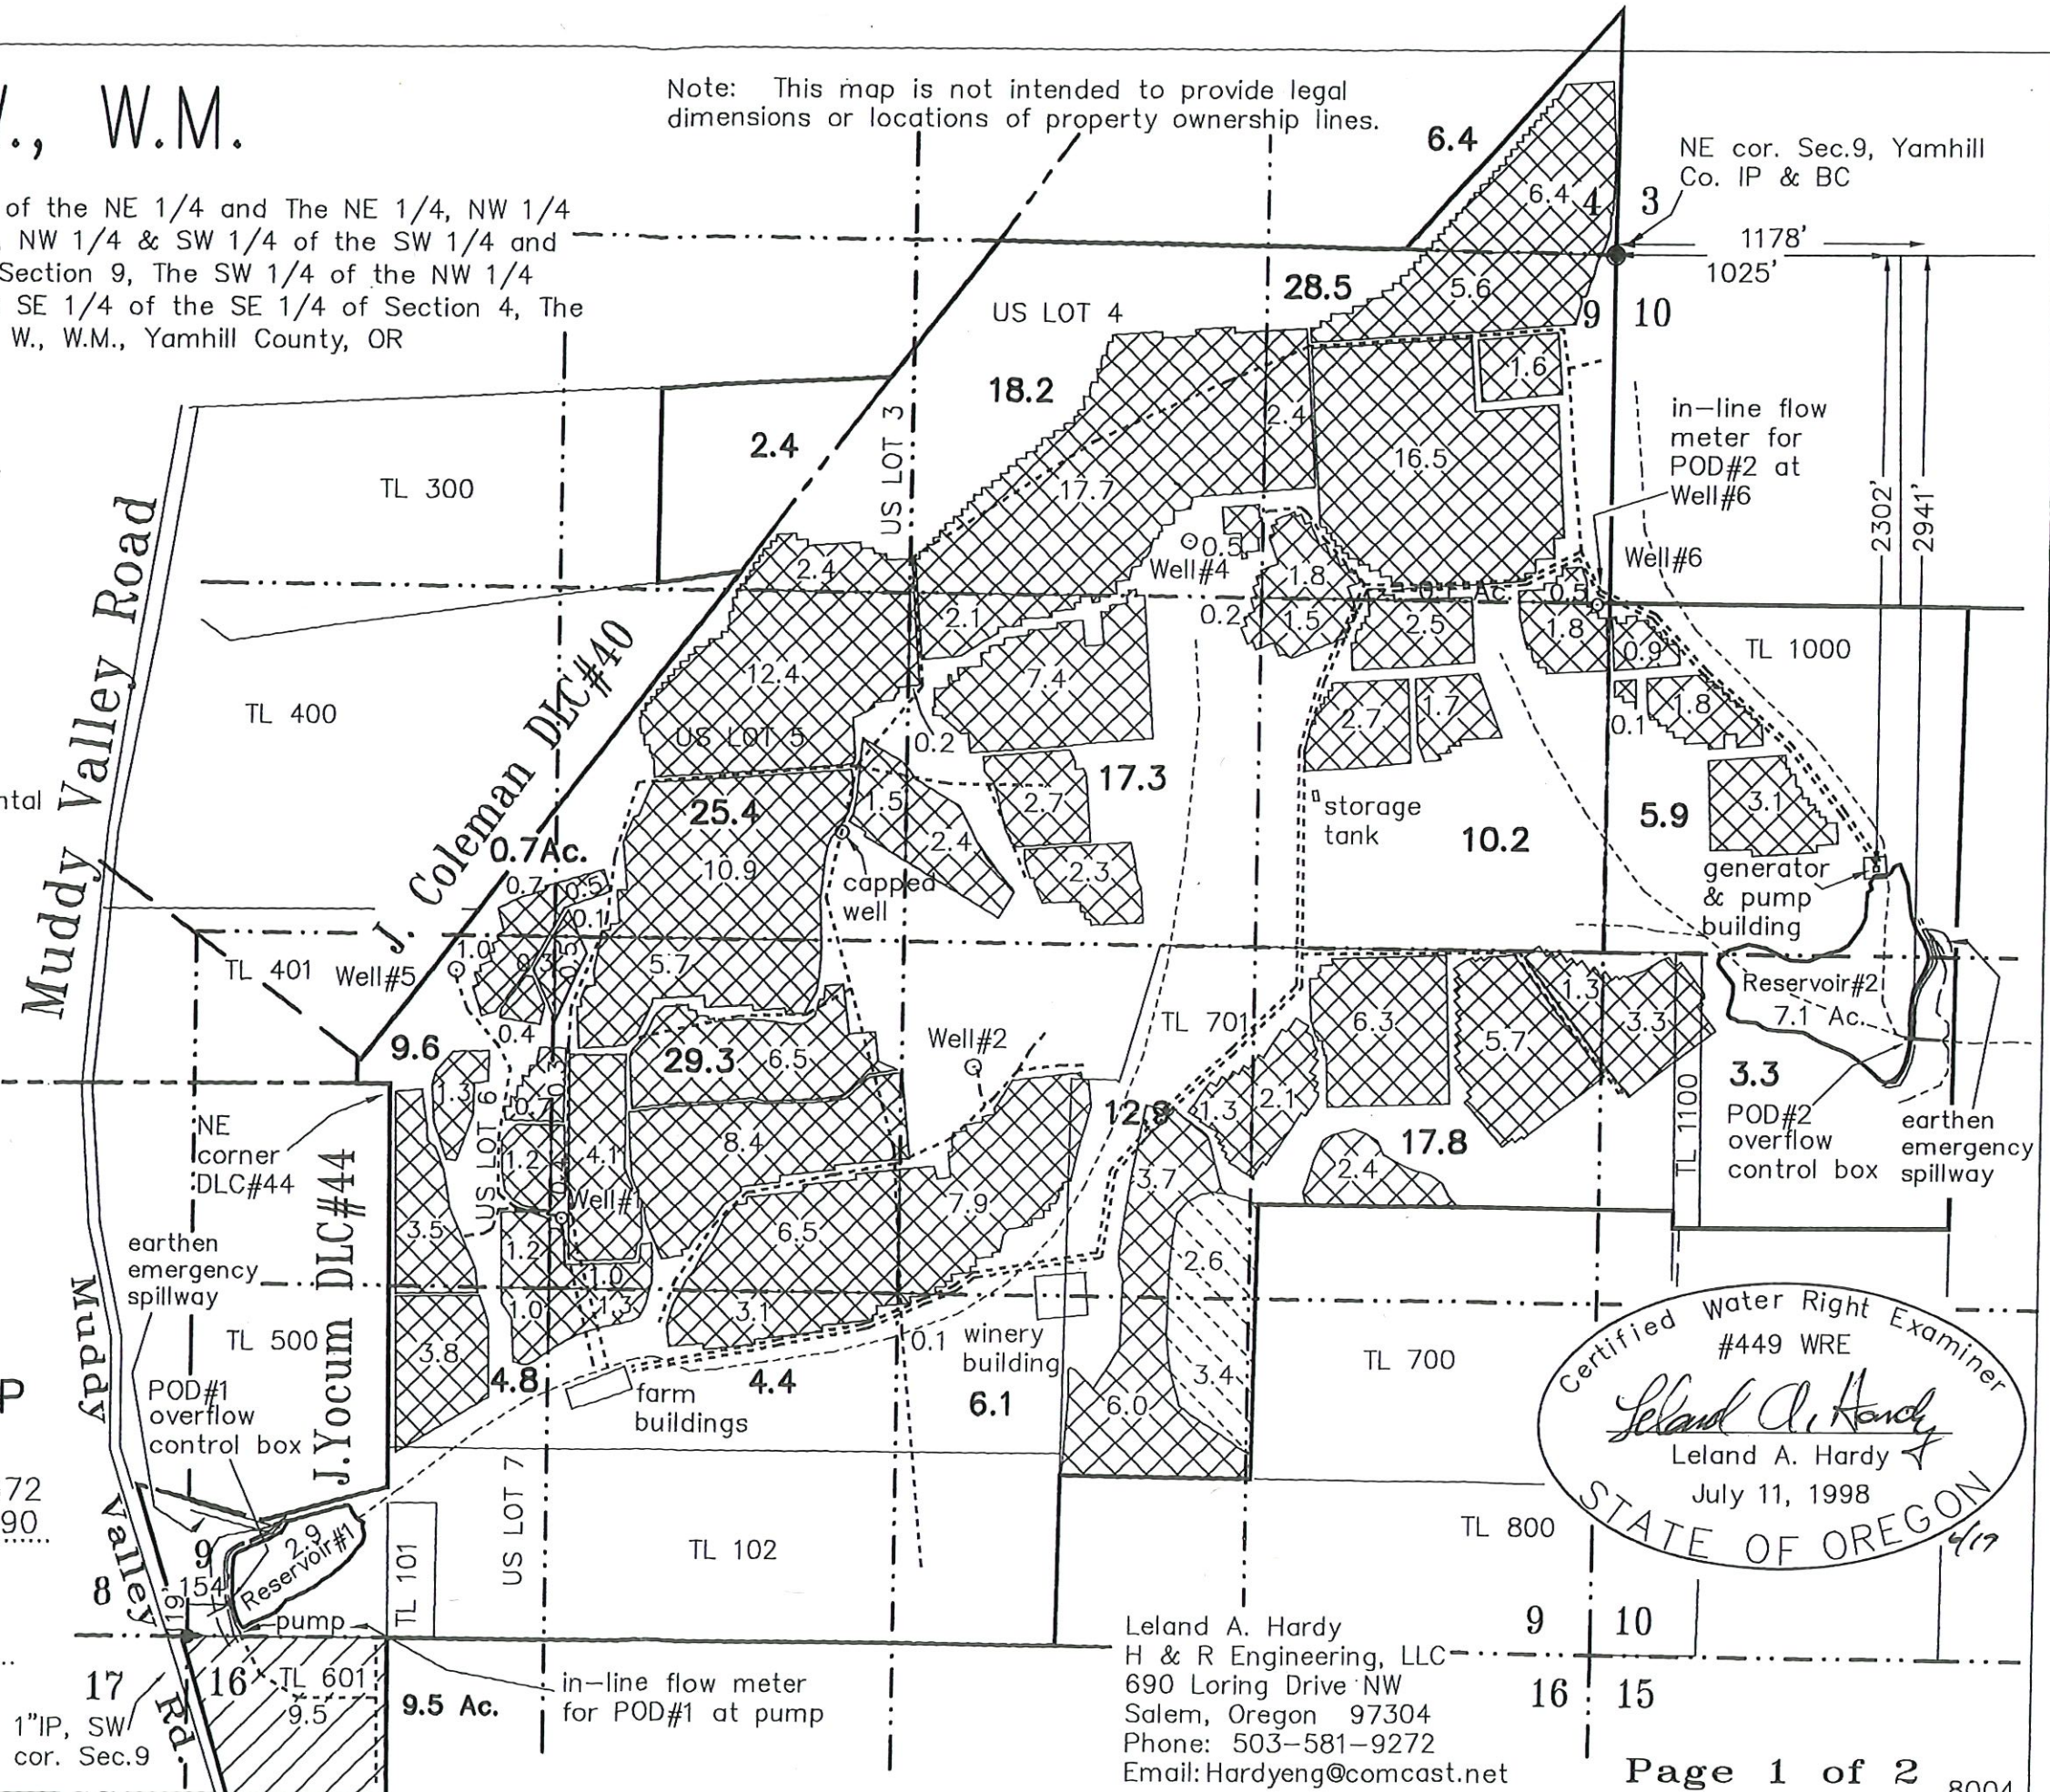
Application No. G-15085

Permit No. G-13990

IN NAME OF

MOMTAZI FAMILY, LLC

Surveyed July, 2015



North

1" IP, SW  
cor. Sec.9

Certified Water Right Examiner  
#449 WRE  
*Leland A. Hardy*  
Leland A. Hardy  
July 11, 1998  
STATE OF OREGON

Leland A. Hardy  
H & R Engineering, LLC  
690 Loring Drive NW  
Salem, Oregon 97304  
Phone: 503-581-9272  
Email: Hardyeng@comcast.net