
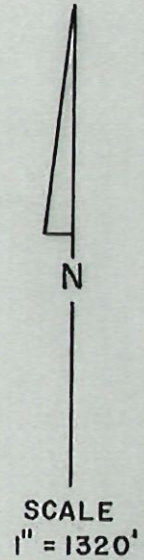


T. 9 S., R. 5 W., W. M.

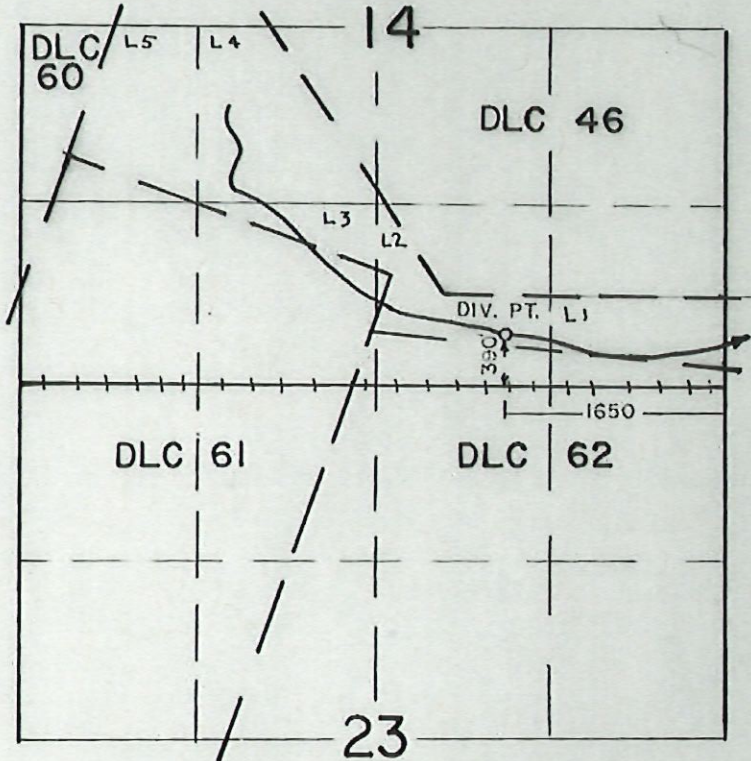

FINAL PROOF SURVEY
 UNDER

TRANSFER 3727
 IN NAME OF

DOROTHY DAVIES

Surveyed SEP. 5. 1984, by P. PAGTER

T. 9 S., R. 5 W., W.M.



FINAL PROOF SURVEY

UNDER

25360

19883

Application No. 23001 Permit No. 18194

IN NAME OF

James Russell Oswald

Anna M. Rutschman

Surveyed Aug. 2, 1954, by T. Jones

DPE-2D-173