

CLAIM OF BENEFICIAL USE MAP

TO ADD A POINT OF APPROPRIATION & PLACE OF USE

FOR APPLICATION G-17996

WILKS RANCH TEXAS, LTD.

TOWNSHIP 14 SOUTH, RANGE 39 EAST, W.M.

TAX LOTS: 300 & 2000

◆ SYSTEM BULGE (POND A)
LOCATED IN THE SE 1/4 NW 1/4 SECTION 14, T14S, R39E, W.M.
0.85 AF 7 FT DEEP DUGOUT POND
24" CMP INLET NW END
24" CMP OVERFLOW TO E'LY POND
24" CMP OUTLET TO E'LY POND

◆ SYSTEM BULGE (POND B)
LOCATED IN THE SE 1/4 SE 1/4 SECTION 9, T14S, R39E, W.M.
0.85 AF 7 FT DEEP PARTIALLY DUGOUT POND
24" CMP INLET NW END
(2) 12" CMP OUTLET TO N & S CANALS


415.2 ACRES IS FROM PERMIT
G-17803, AS SHOWN.

POU LV FROM PERMIT
G-17803, AS SHOWN.

POU IM FROM PERMIT
G-17803, AS SHOWN.

POU D1 & D2 FROM PERMIT
G-17803, AS SHOWN.


● PROPOSED WELL #1 (MALH 54260) IS LOCATED 900 FEET
NORTH AND 2725 FEET EAST FROM THE SW CORNER OF
SECTION 14.

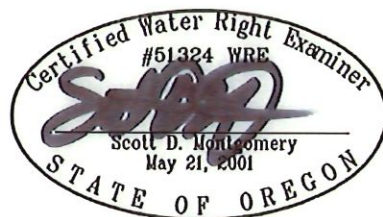

RENEWAL DATE: 12/31/2026

THIS MAP IS FOR THE PURPOSE OF LOCATING A WATER
RIGHT ONLY AND HAS NO INTENT TO PROVIDE LEGAL
DIMENSIONS OR THE LOCATION OF PROPERTY LINES.

SCALE: 4 INCHES = 1 MILE

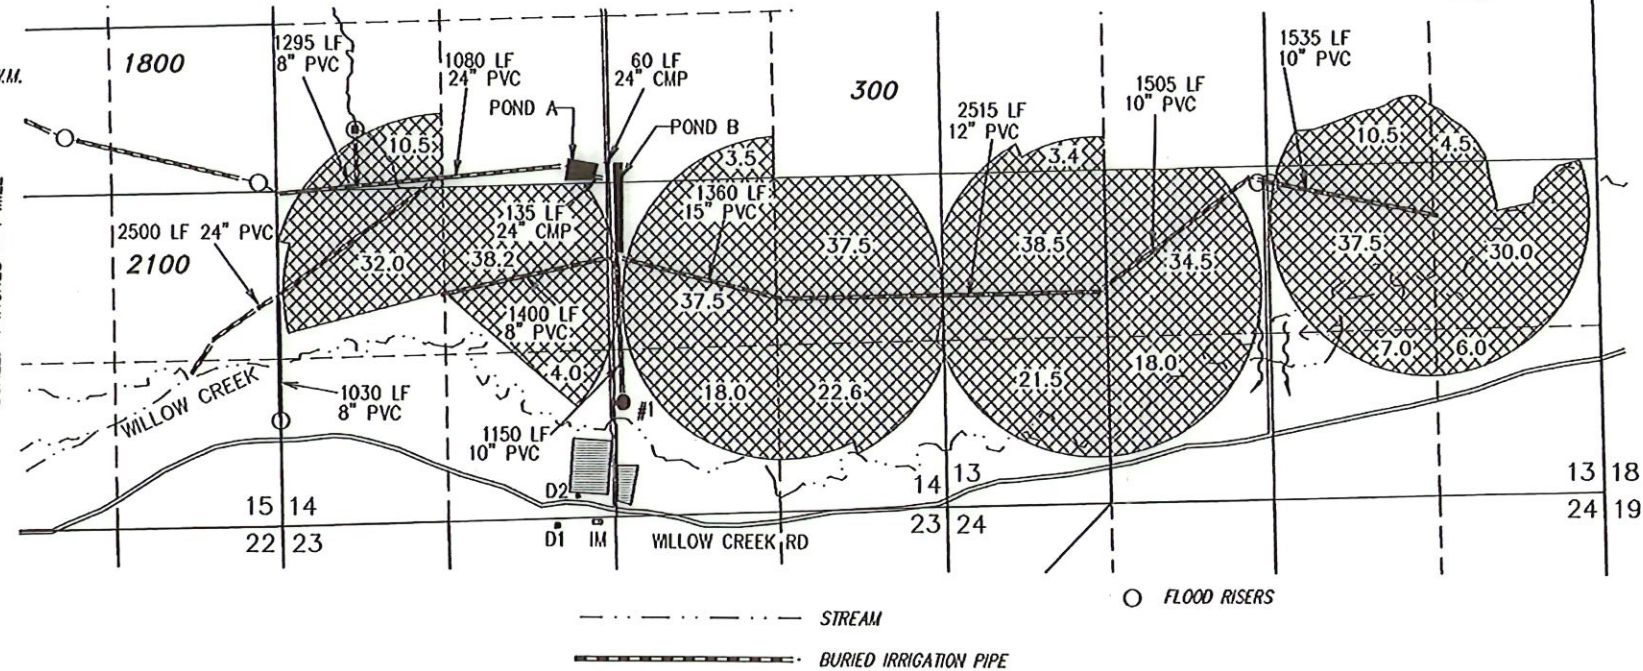

Received
JUN 12 2025
OWRD

PREPARED FOR:

WILKS RANCH OREGON LTD.
4945 WILLOW CREEK ROAD
IRONSIDE, OR 97908

PREPARED BY:



ALL POINTS ENGINEERING AND SURVEYING, INC.
P.O. BOX 767 TERREBONNE, OR 97760
(541) 548-5833 www.APEandS.com