


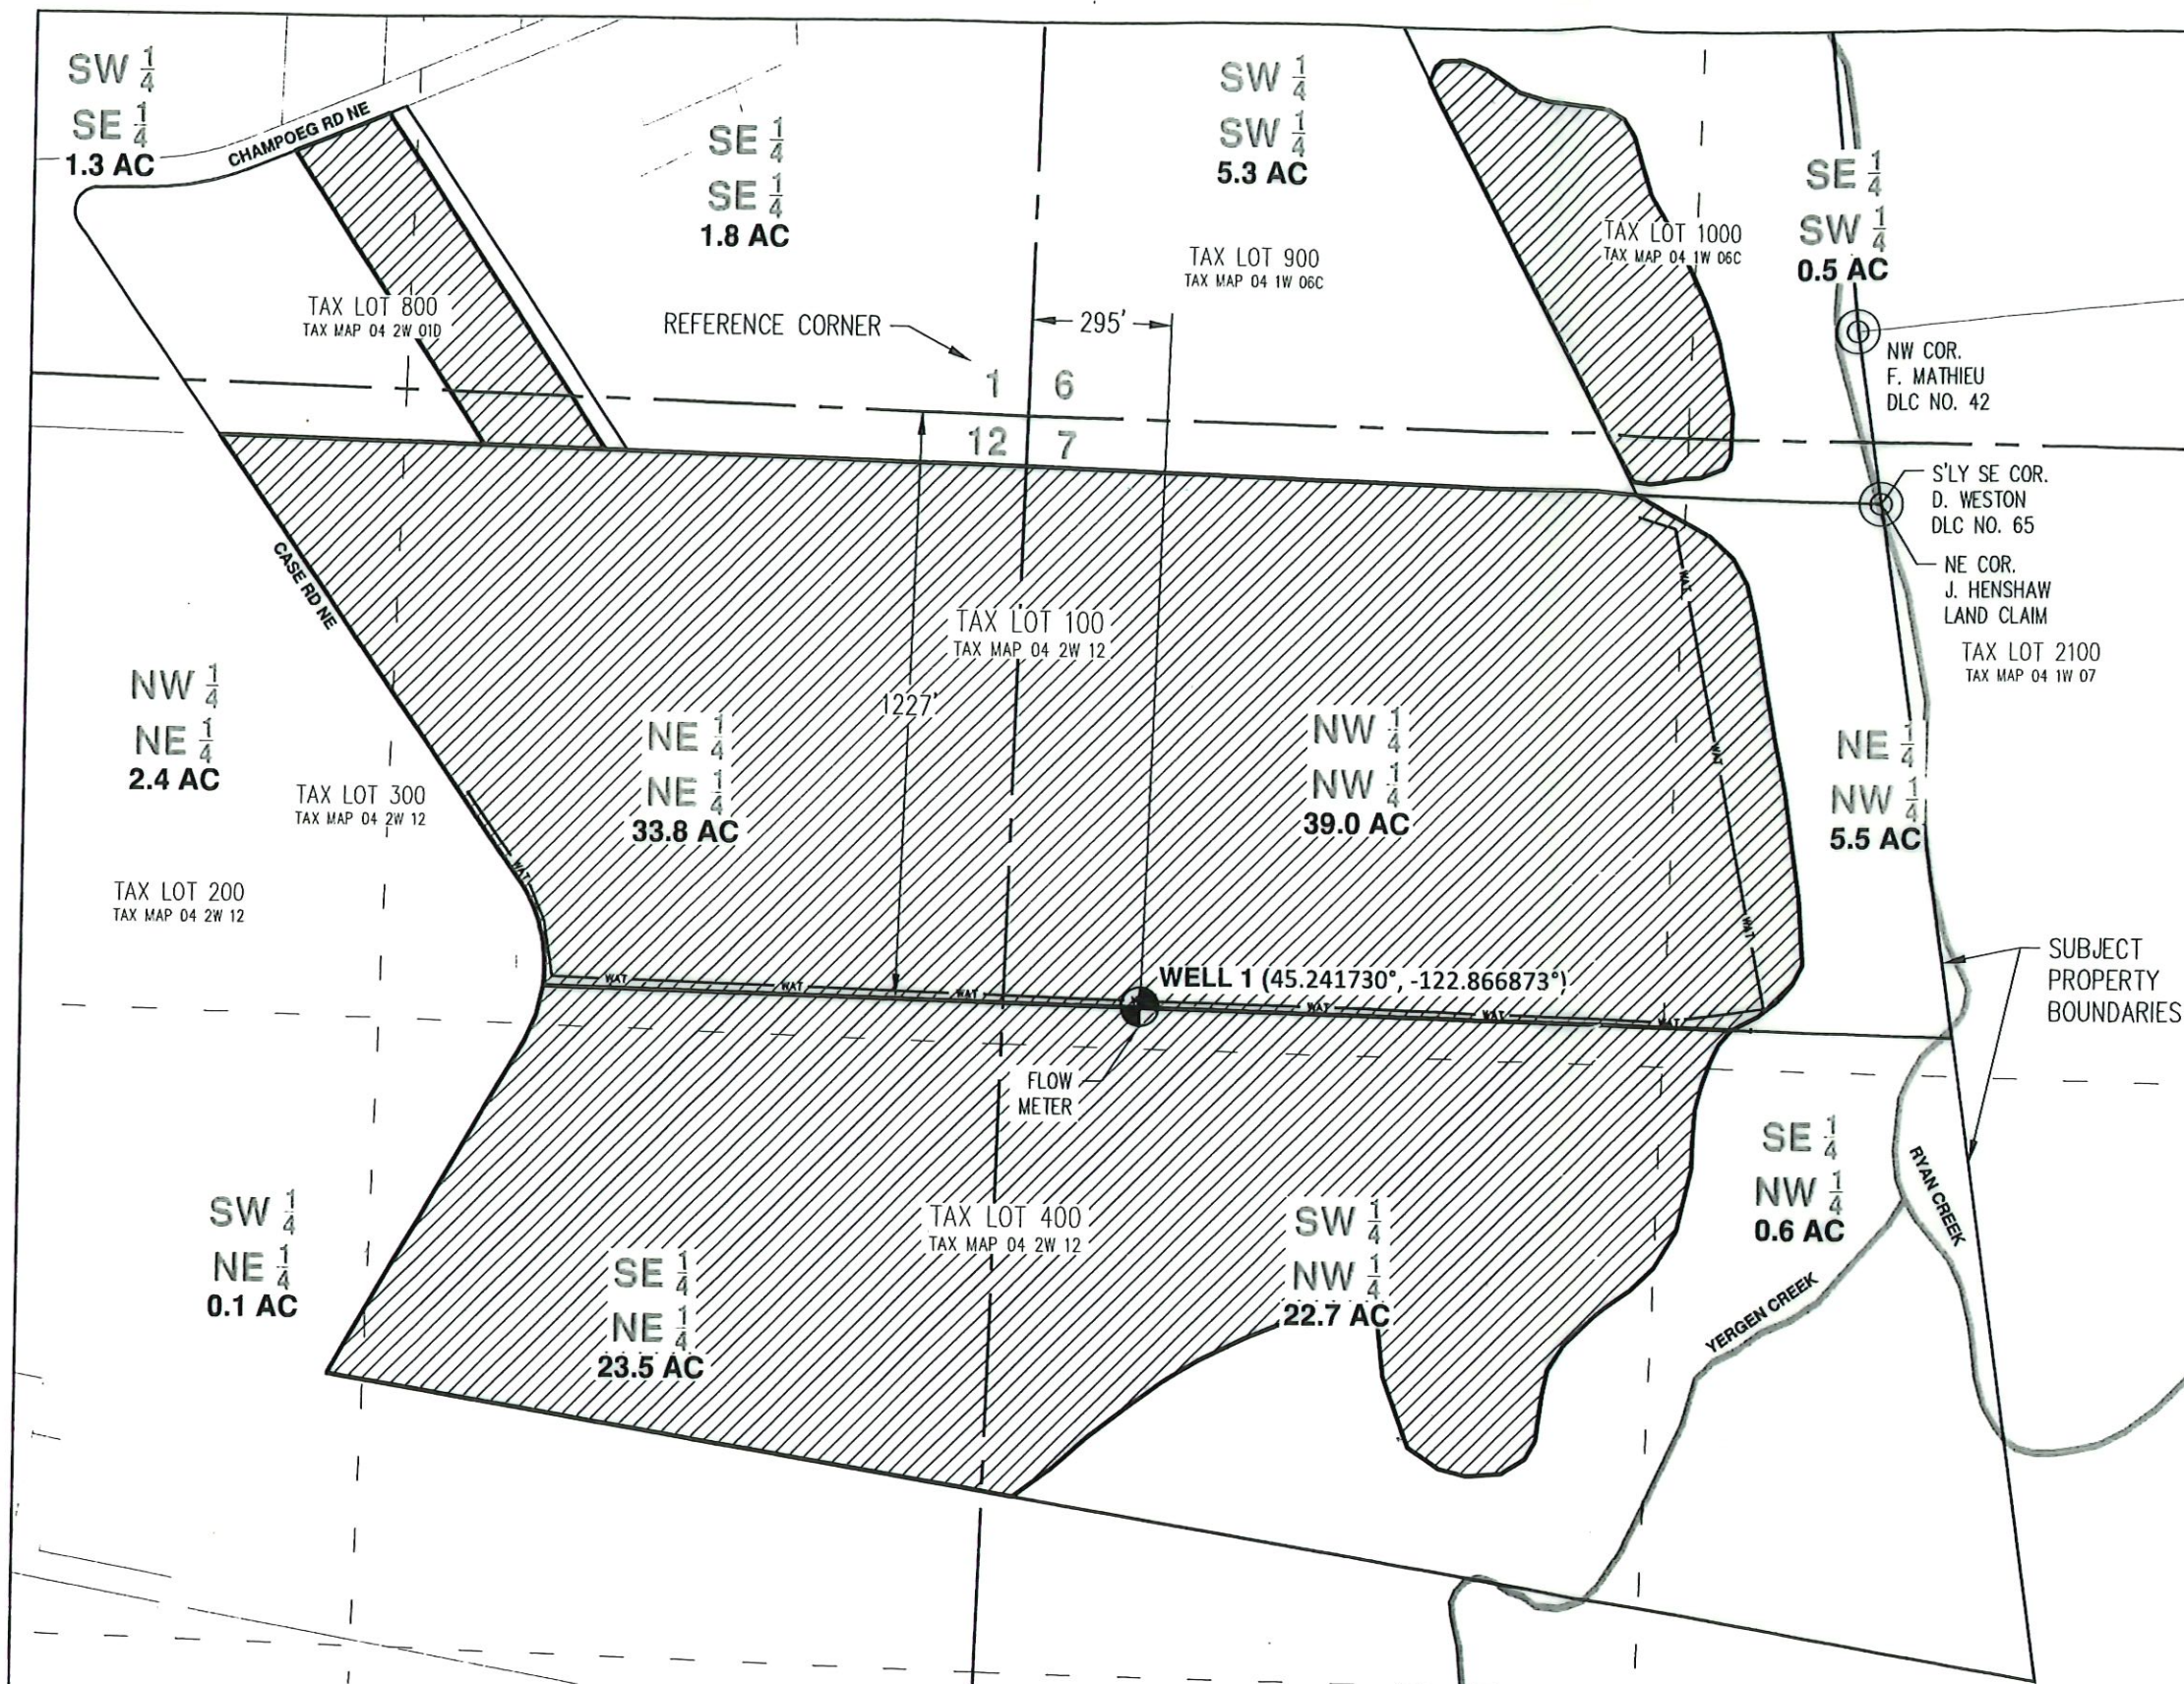


LOCATED IN  
SECTIONS 1D & 12; T4S R2W W.M.  
& SECTIONS 6C & 7; T4S R1W W.M.  
MARION COUNTY, OREGON

# CLAIM OF BENEFICIAL USE MAP

APPLICATION G-17917  
PERMIT G-17651

|                                   |                                  |
|-----------------------------------|----------------------------------|
| TAX LOT 100<br>TAX MAP 04 2W 12   | TAX LOT 400<br>TAX MAP 04 2W 12  |
| TAX LOT 1000<br>TAX MAP 04 1W 06C | TAX LOT 800<br>TAX MAP 04 2W 01D |

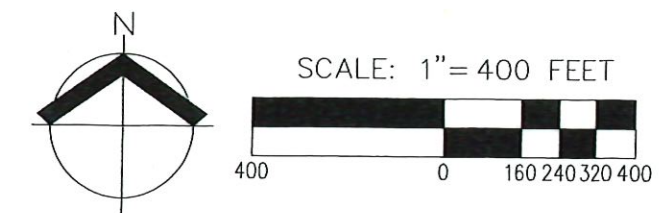

**CWRE STATEMENT**  
THIS MAP IS NOT INTENDED TO PROVIDE LEGAL DIMENSIONS OF  
LOCATIONS OF PROPERTY OWNERSHIP LINES.

**MAP INFORMATION**  
COORDINATE SYSTEM: STATE PLANE OREGON NORTH ZONE 3601  
DATUM: NORTH AMERICAN DATUM OF 1983

**DATA SOURCES**  
TAX LOT AND ROAD: MARION COUNTY GIS  
SECTION LINEWORK: MARION COUNTY GIS

**PREPARED FOR**  
GARY ROSHAK  
PO BOX 247, SHERWOOD, OR 97140

RECEIVED  
APR 14 2021  
OWRD

DATE: 02/22/2021

**LEGEND**

POINT OF APPROPRIATION (POA)  
TAX LOT BOUNDARY  
1/4 1/4 SECTION LINE  
SECTION LINE

IRRIGATION MAINLINE  
PRIMARY IRRIGATION USE  
TOTAL = ±136.5 ACRES  
ACRES PER 1/4 1/4 SECTION  
###.# AC



|   |  |                                            |
|---|--|--------------------------------------------|
| <b>CLAIM OF BENEFICIAL USE MAP</b>                                                                                       |  | EXHIBIT<br><b>1 OF 1</b>                   |
| <b>ROSHAK AURORA WATER RIGHTS</b>                                                                                        |  |                                            |
| AKS ENGINEERING & FORESTRY, LLC<br>12965 SW HERMAN ROAD, SUITE 100<br>TUALATIN, OR 97062<br>503.563.6151 WWW.AKS-ENG.COM |  | DRWN: SRR<br>CHKD: JPC<br>AKS JOB:<br>7554 |

