



Claim of Beneficial Use - Immaculate Conception Church
 Application G-18484, Permit G-17973

Township 9S, Range 1W, W.M.

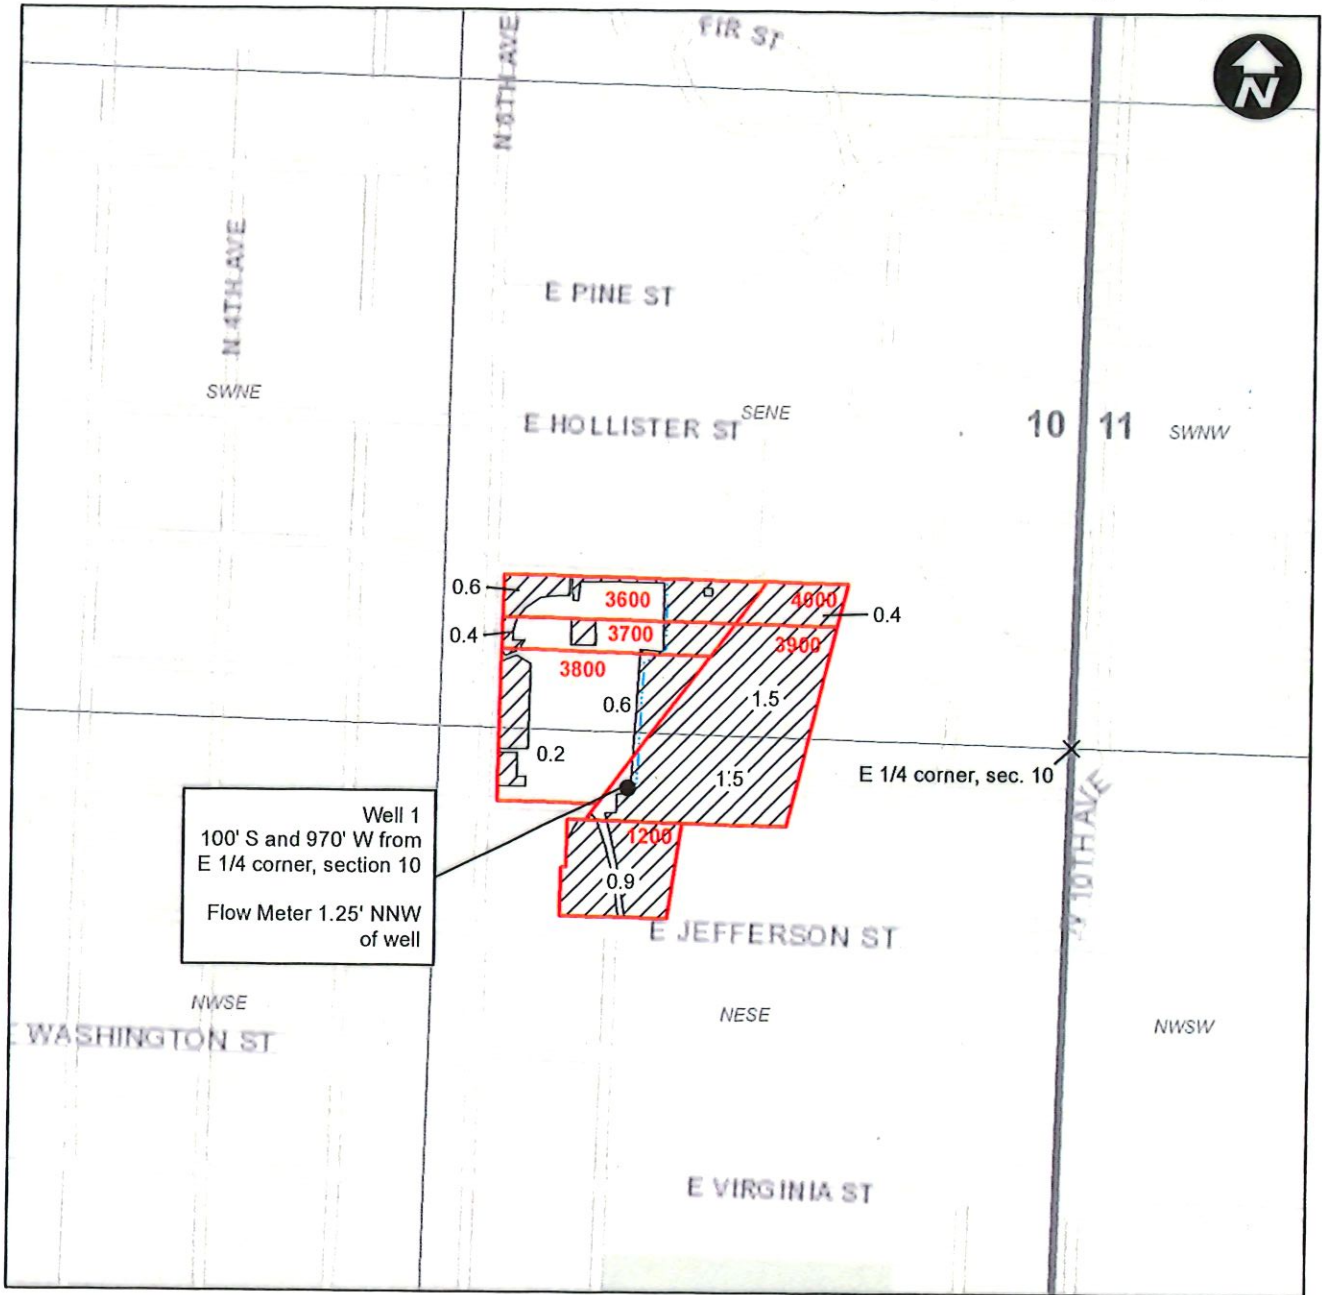

Well 1
 100' S and 970' W from
 E 1/4 corner, section 10
 Flow Meter 1.25' NNW
 of well

This map is not intended to provide legal dimensions or locations of property ownership lines.

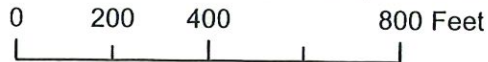

Legend

- IR POU
- Mainline
- Taxlot



NOV 25 2024

EXPIRES: 12-31-2024