


T.3S. R.3W. Section 4, W.M.

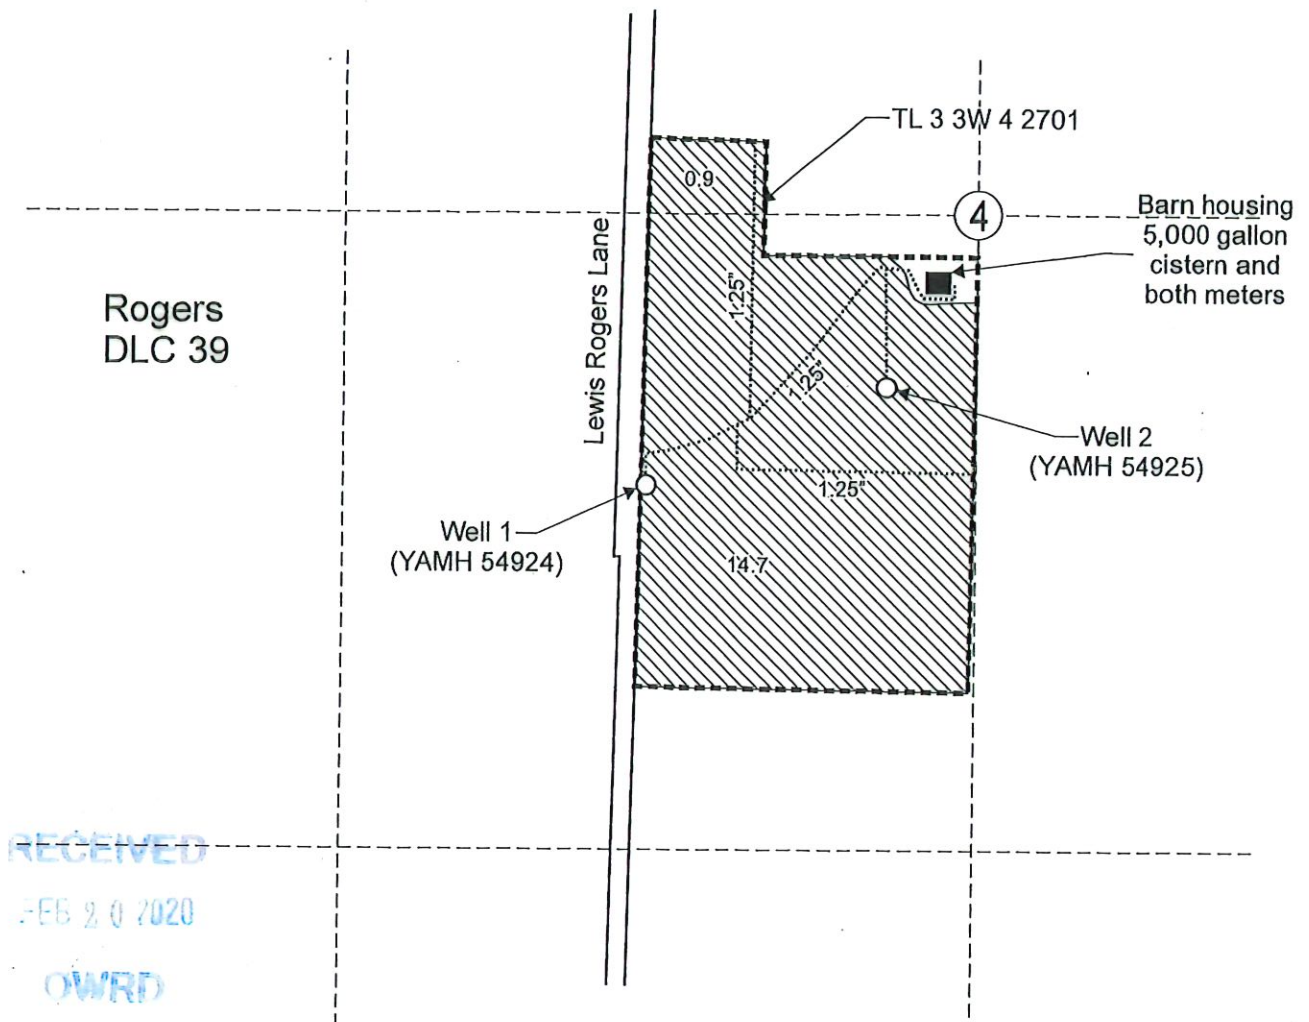

RECEIVED
FEB 20 2020
OWRD

Well 1 (YAMH 54924) is located 565 feet south and 685 feet west from the C1/4 corner, Section 4.
Well 2 (YAMH 54925) is located 360 feet south and 185 feet west from the C1/4 corner, Section 4.

Area (15.6 Acres) to be irrigated.


----- Tax lot boundary

..... Mainlines



DOANN M. HAMILTON
JUNE 30 2021

Scale: 1" = 400'

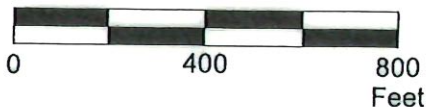

This map was prepared for the purpose of identifying the location of a water right only and is not intended to provide legal dimensions or location of property ownership lines.

Claim of Beneficial Use Map
Application G-17759, Permit G-17329

Doug Ackerman
T.3S. R.3W Section 4, W.M.

Pacific Hydro-Geology Inc.

01/2020