


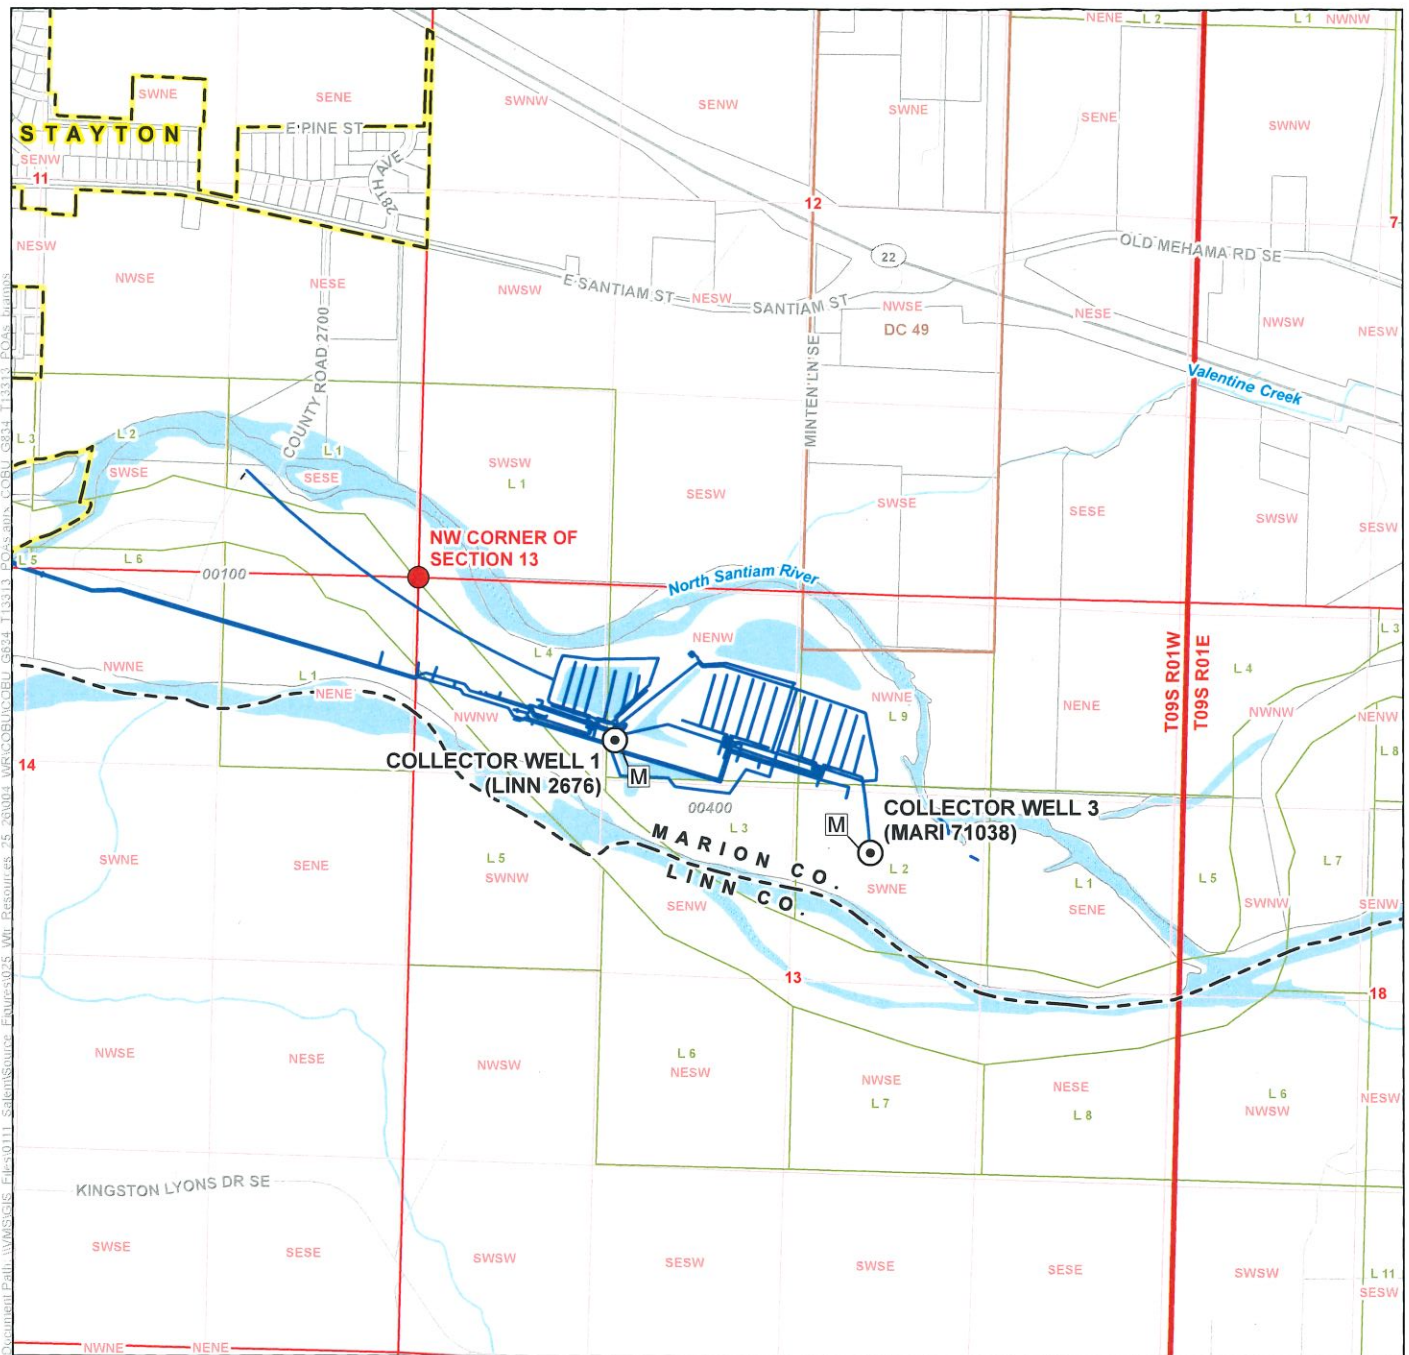

LEGEND


- Point of Appropriation (POA)
- Meter
- Water Main Line
- All Other Features**
- County Boundary

- Tax Lot
- Major Road
- Watercourse
- Waterbody

Claim of Beneficial Use Map City of Salem Application G-834; Transfer T-13313 Points of Appropriation

Township 09 South, Range 01 West (W.M.)

CERTIFIED WATER RIGHTS EXAMINER STAMP

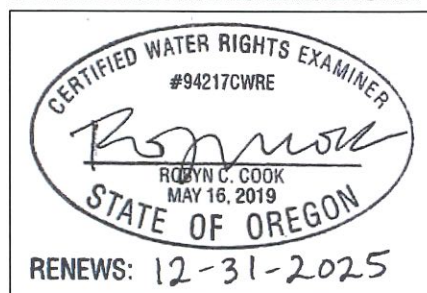

Received
NOV 10 2025
OWRD


POA LOCATION DESCRIPTIONS


Collector Well 1 (LINN 2676)
Located 980 feet South and 1,450 feet East from the NW corner of Section 13, Township 9 South, Range 1 West (W.M.)

Collector Well 3 (MARI 71038)
Located 1,815 feet South and 3,155 feet East from the NW corner of Section 13, Township 9 South, Range 1 West (W.M.)

DISCLAIMER
This map was prepared for the purpose of identifying the location of a water right only and it is not intended to provide legal dimensions or location of property ownership lines.

Date: September 17, 2025
Data Sources: BLM, ESRI, OWRD, USGS

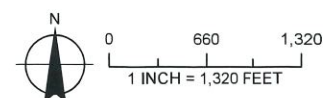

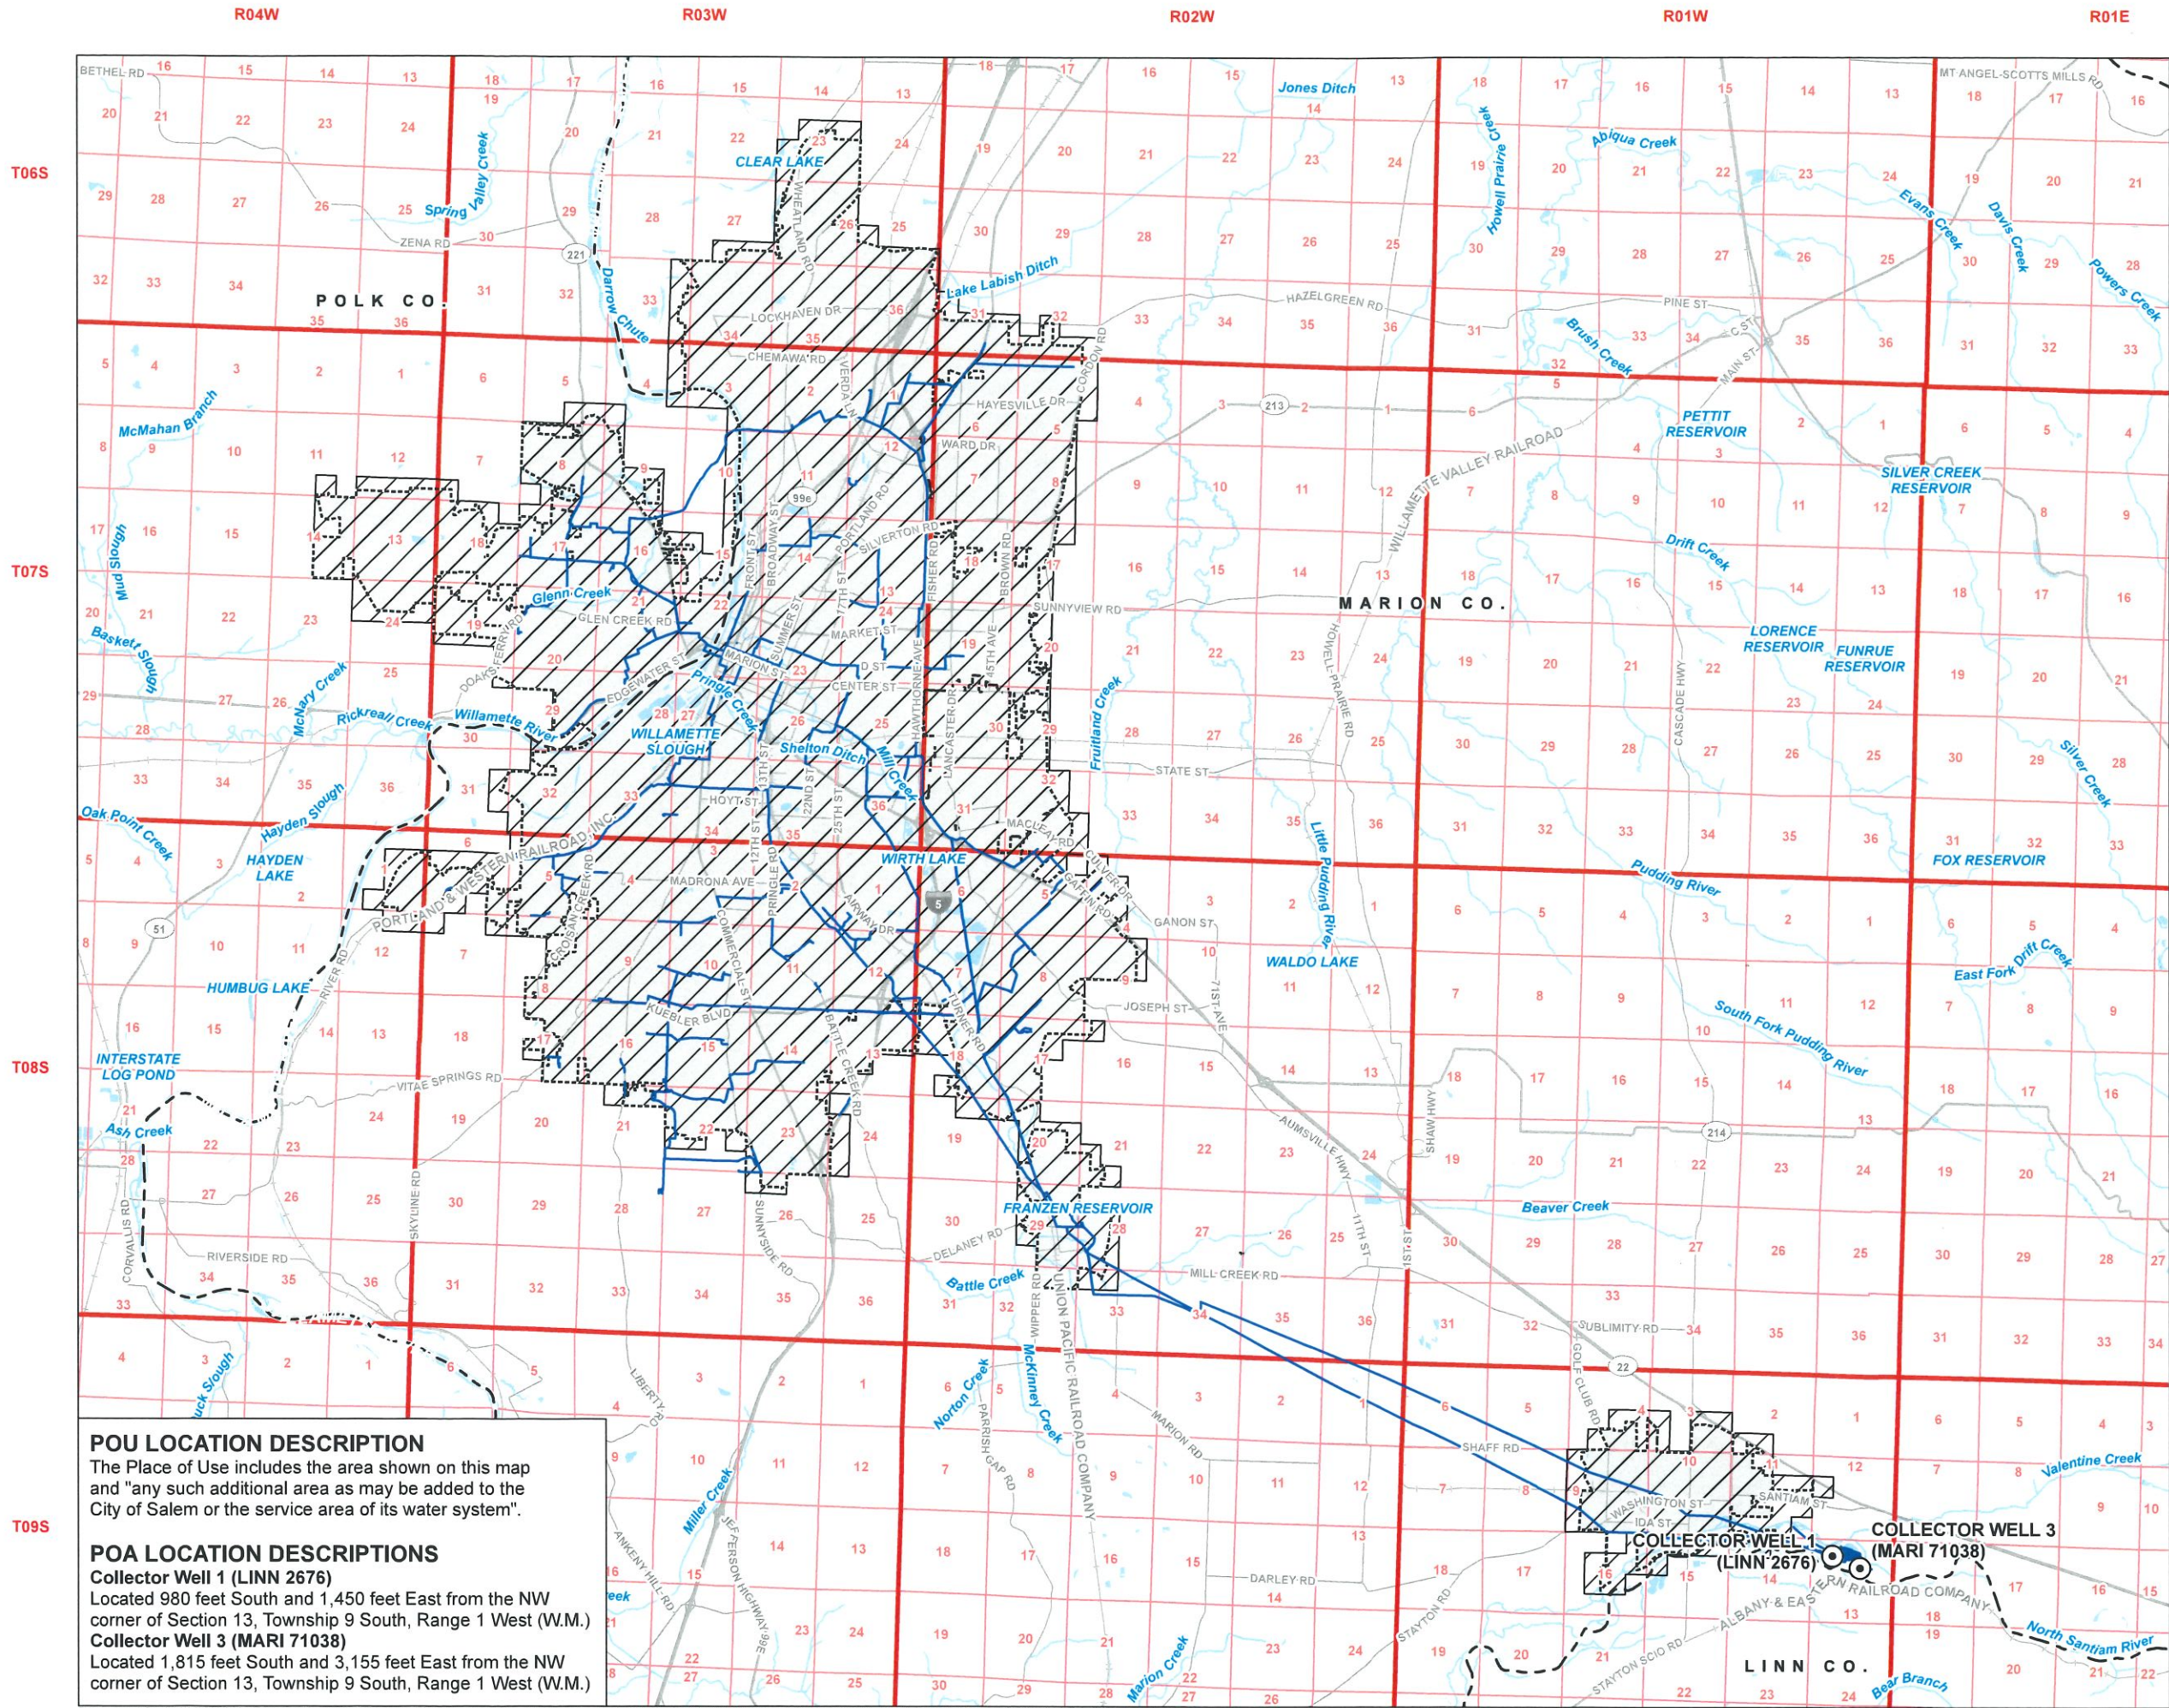

Claim of Beneficial Use Map

City of Salem

Application G-834; Transfer T-13313

Place of Use Map


Township 6, 7, 8, 9 South,
Range 1, 2, 3, 4 West (W.M.)

LEGEND

- Point of Appropriation (POA)
- Water Main Line
- Place of Use (POU)
- Water Service Area
- All Other Features
 - County Boundary
 - Major Road
 - Railroad
 - Watercourse
 - Waterbody

Received
NOV 10 2025
OWRD

CERTIFIED WATER RIGHTS EXAMINER STAMP

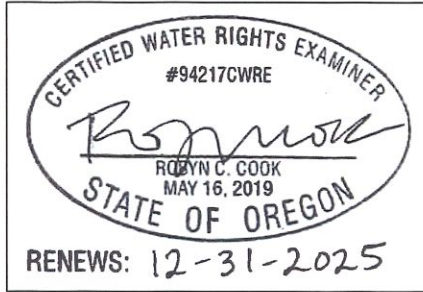

DISCLAIMER

This map was prepared for the purpose of identifying the location of a water right only and it is not intended to provide legal dimensions or location of property ownership lines.



Date: September 17, 2025
Data Sources: BLM, ESRI, ODOT, USGS

POU LOCATION DESCRIPTION

The Place of Use includes the area shown on this map and "any such additional area as may be added to the City of Salem or the service area of its water system".

POA LOCATION DESCRIPTIONS

Collector Well 1 (LINN 2676)

Located 980 feet South and 1,450 feet East from the NW corner of Section 13, Township 9 South, Range 1 West (W.M.)

Collector Well 3 (MARI 71038)

Located 1,815 feet South and 3,155 feet East from the NW corner of Section 13, Township 9 South, Range 1 West (W.M.)