


T5S, R2W, Sections 22 & 23

This map is not intended to provide legal dimensions or locations of property ownership lines.

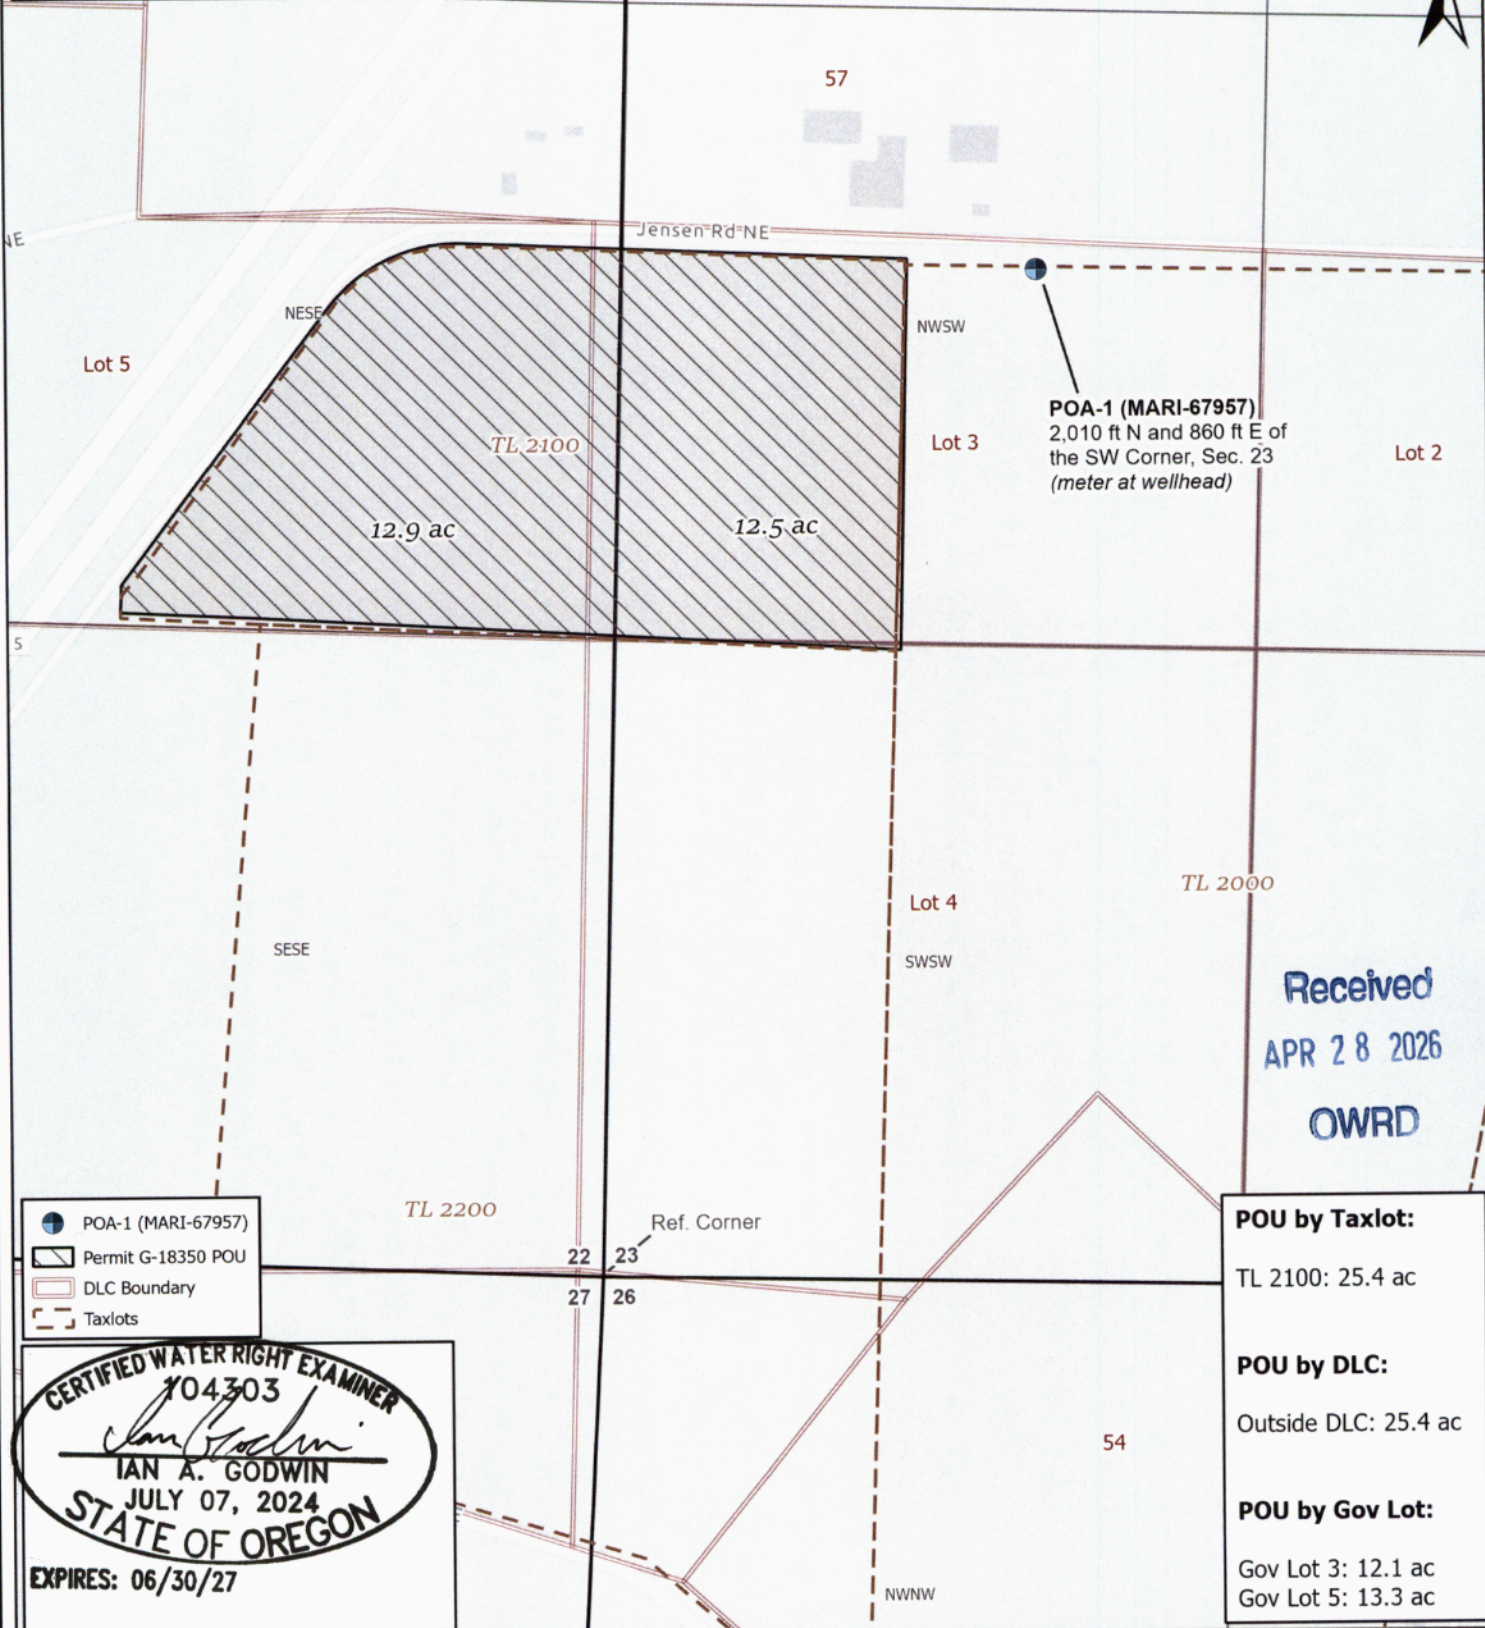

Received  
APR 28 2026  
OWRD

- POA-1 (MARI-67957)
- Permit G-18350 POU
- DLC Boundary
- Taxlots

**CERTIFIED WATER RIGHT EXAMINER**  
 704303  
  
**IAN A. GODWIN**  
 JULY 07, 2024  
**STATE OF OREGON**  
 EXPIRES: 06/30/27

**POU by Taxlot:**  
 TL 2100: 25.4 ac


**POU by DLC:**  
 Outside DLC: 25.4 ac

**POU by Gov Lot:**  
 Gov Lot 3: 12.1 ac  
 Gov Lot 5: 13.3 ac

**CwM-H2O**   
 Complete Water Management

311 B Avenue, Suite P  
 Lake Oswego, Oregon 97034  
 (503) 954-1326

**Attachment 1**  
**Claim of Beneficial Use Map**  
**App. G-18800, Permit G-18350**

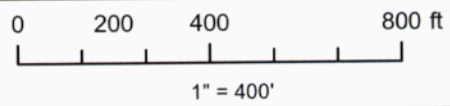

No.	Date	By	Revisions
1	DATE	AUTH	DRAFT

**Proj#: 2524002**  
**Crosby CoBUs**  
 Crosby Hop Farm, LLC  
 8648 Crosby Rd NE  
 Woodburn, OR 97071