


Section 25, T27S, R15E, WM (Lake County)

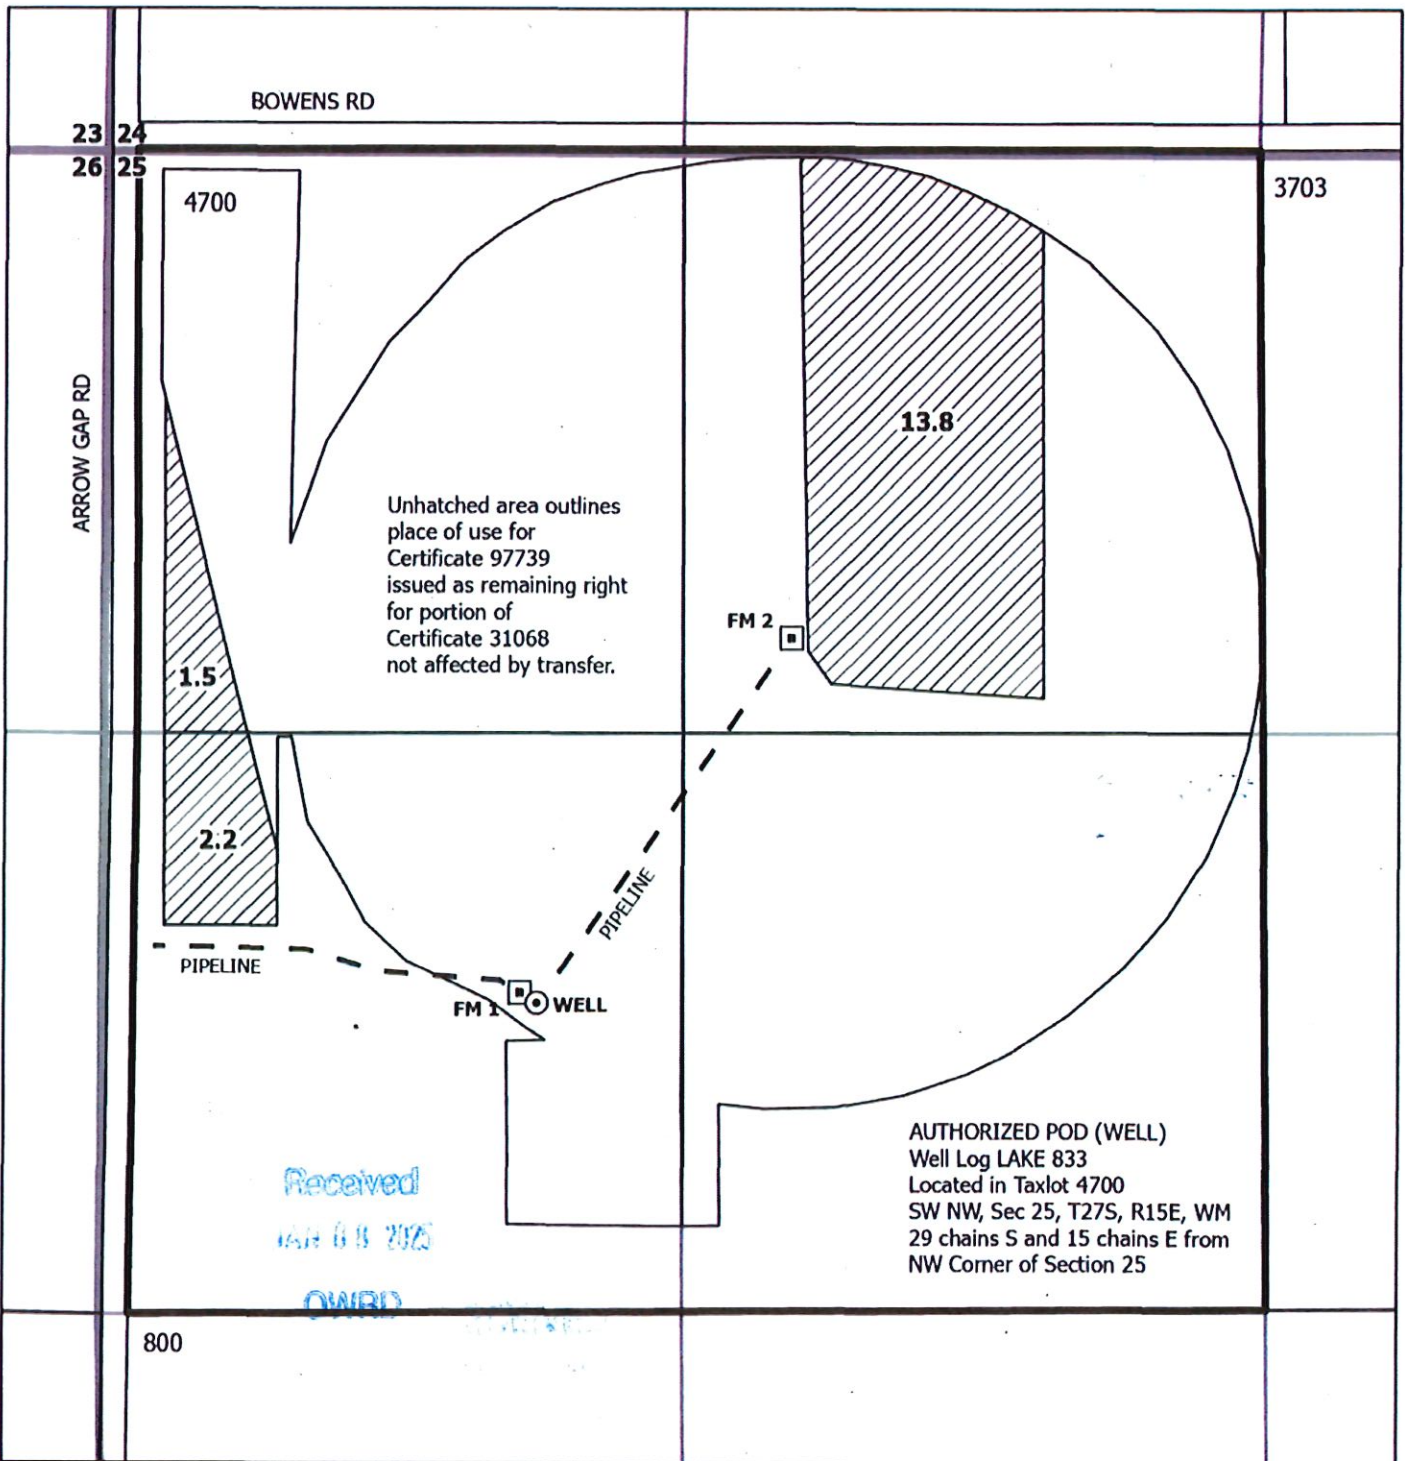


AUTHORIZED POD (WELL)
Well Log LAKE 833
Located in Taxlot 4700
SW NW, Sec 25, T27S, R15E, WM
29 chains S and 15 chains E from
NW Corner of Section 25

DISCLAIMER
This map is not intended
to provide legal dimensions
or locations of property
ownership lines.



0 100 200 400 US Feet
[Scale bar with 4 segments]

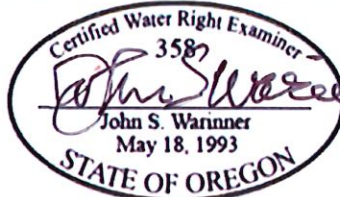

WATERSOLVING LLC
johnw@watersolving.com
(541) 815-4103 mobile

CLAIM OF BENEFICIAL USE MAP

TRANSFER 14025
Certificate 31068
Change Place of Use

CAROL CHUGG
Revised 2024-12-27