












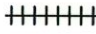

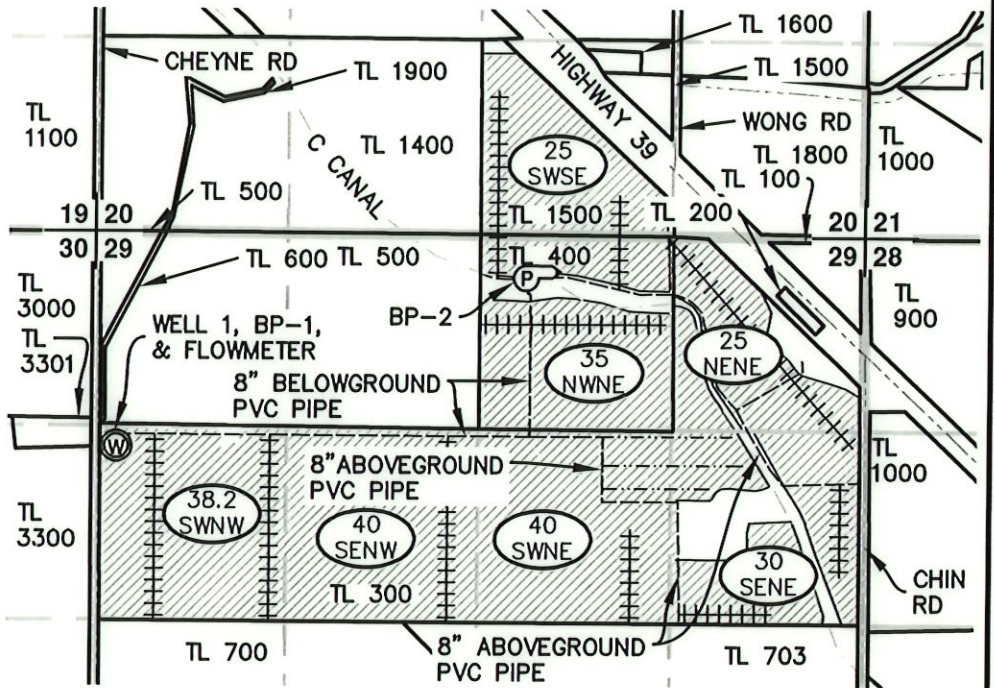
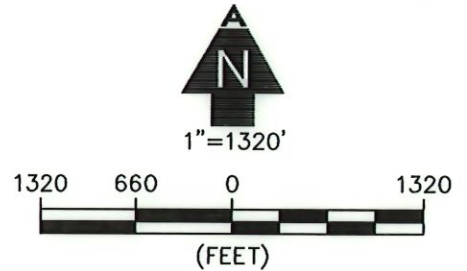


LEGEND

-  TOWNSHIP LINE
-  SECTION LINE
-  1/4 1/4 LINE
-  TAX LOT LINE
-  ROAD
-  CANAL
-  MAINLINE
- TL 0000** TAX LOT NUMBER
-  POA (WELL)
-  IRRIGATED ACRES
-  IRRIGATED ACRES
1/4 1/4 SECTION
-  FLOW DIRECTION
-  SECTION CORNER
-  PUMP
-  WHEEL LINE
-  SOLID SET LINE

 

RECEIVED
DEC 12 2018
OWRD

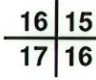


WELL TIES

POA-WELL 1: SW 1/4 NW1/4, SECTION 29, T40S, R10E, W.M.; 1420 FEET SOUTH & 20 FEET EAST FROM NW CORNER, SECTION 29.

NOTES

1. THIS MAP WAS PREPARED FROM FIELD MEASUREMENTS, 2014 NAIP AERIAL IMAGERY, AND KLAMATH COUNTY TAX MAPS T40S, R10E, SEC. 20 AND SEC. 29.
2. THIS MAP IS FOR THE PURPOSE OF IDENTIFYING THE LOCATION OF THE WATER RIGHT ONLY AND HAS NO INTENT TO PROVIDE DIMENSIONS OR LOCATION OF PROPERTY LINES.
3. FOR TAX LOT INFORMATION, SEE TAX MAPS T40S R10E SEC. 20 AND 29 INCLUDED WITH THIS COBU.
4. DATE OF PRIORITY FOR THIS CLAIM IS MAY 29, 2001.


APPLICANT

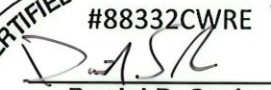CERTIFIED WATER RIGHT EXAMINER
#88332CWRE

Daniel B. Scalas
April 23, 2015
STATE OF OREGON
RENEWAL 06/30/20

ADKINS
CONSULTING ENGINEERING, LLP
Engineers ▲ Planners ▲ Surveyors
1435 Eplanade Ave · Klamath Falls, Oregon 97601 · (541) 884-4666 · FAX (541) 884-5335
Oregon · California
9/18/2018 2611-02

CLAIM OF BENEFICIAL USE AND FINAL PROOF MAP
FOR
DANIEL CHIN
T40S, R10E, SEC. 20 AND SEC. 29, W.M.
KLAMATH COUNTY, OREGON
APPLICATION No. G-15516
PERMIT No. G-15304