


Township 5 North, Range 29 East, W.M. Umatilla County, Oregon

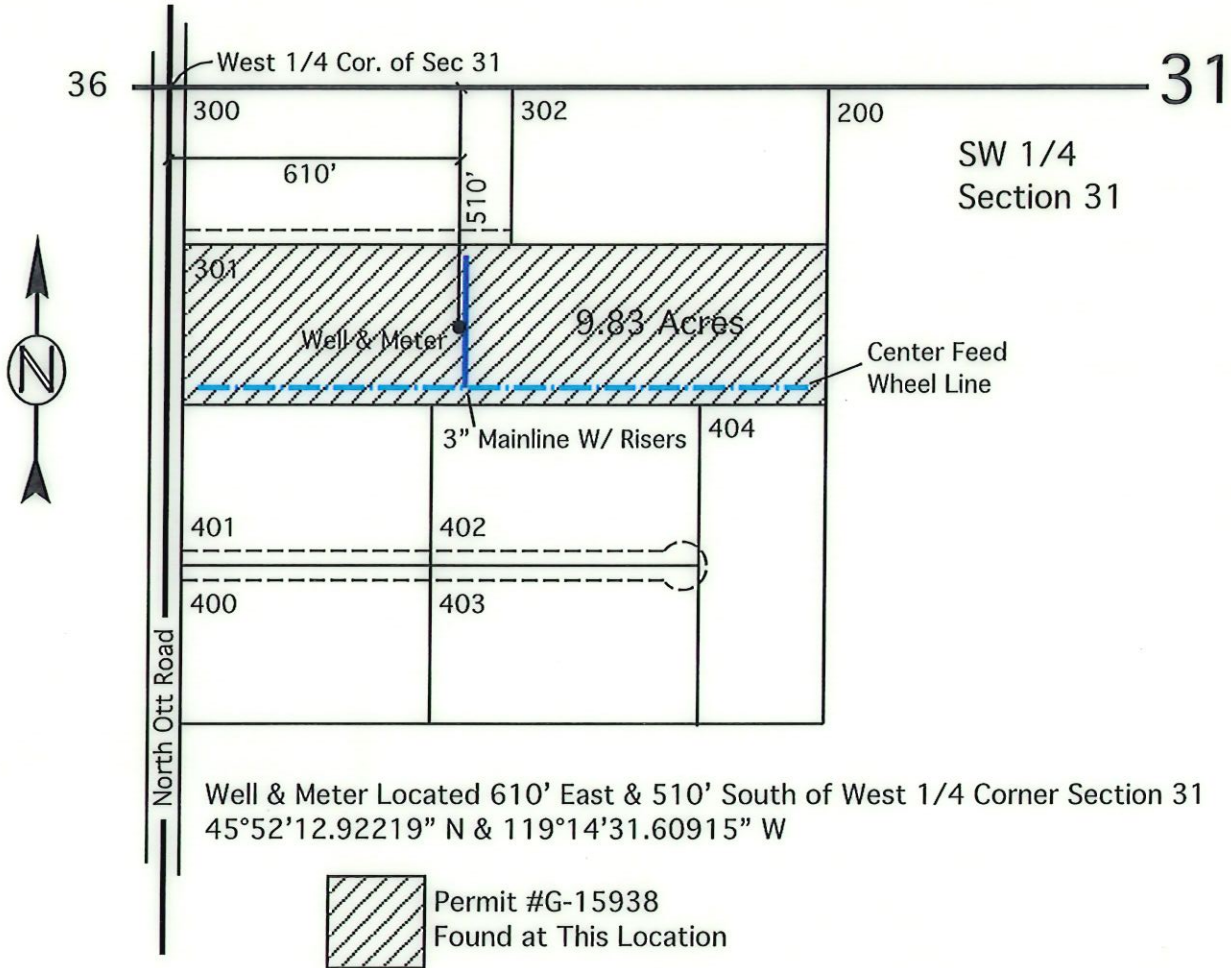

This Map is for the purpose of identifying the location of Water Rights only and is not intended to provide the legal dimensions or locations of property ownership lines.

FINAL PROOF MAP
 In Name Of
Efren & Efrain Lopez

SCALE 1" = 400 Ft.



Expires 12-31-14

ENGINEERING - LAND SURVEYING - WATER RIGHTS

R. V. MCKINNIS ENGINEERING

79980 Prindle Loop Road
 Hermiston, Oregon 97838
 (541) -567-2017

RECEIVED BY OWRI
 JUL 29 2013
 SALEM, OR