


Section 8 T.5S, R.1E, W.M.

CLACKAMAS COUNTY

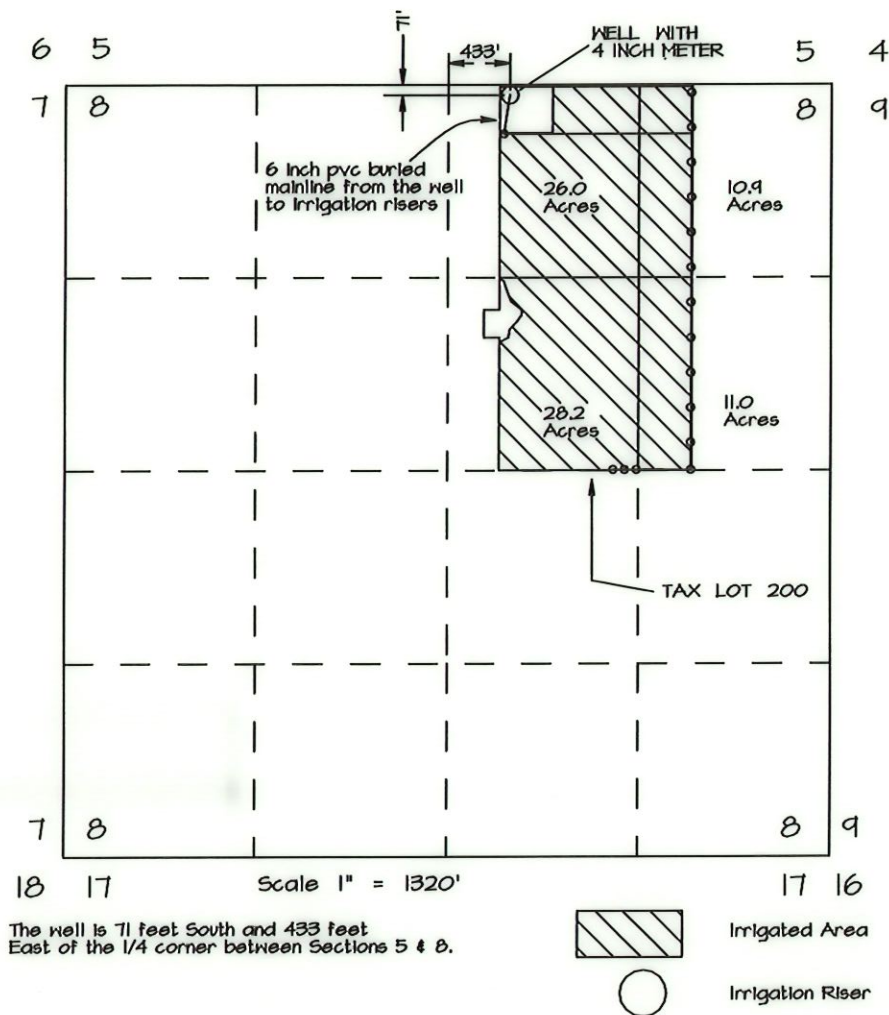


CLAIM OF BENEFICIAL USE MAP
FOR

POSTLEWAIT FARMS

THOMAS POSTLEWAIT

APPLICATION NO. G-16640 PERMIT NO. G-16139

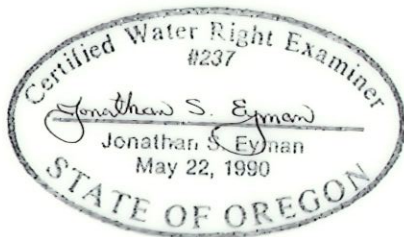

RECEIVED

SEP 06 2016

WATER RESOURCES DEPT
SALEM, OREGON

THE PREPARATION OF THIS MAP IS FOR THE
PURPOSE OF IDENTIFYING THE LOCATION
OF THE WATER RIGHT ONLY AND HAS NO
INTENT TO PROVIDE DIMENSIONS OR LOCATION
OF PROPERTY OWNERSHIP LINES.

Date: 04/19/2014
FILE: P_616139_Post_3c.pro