

T1S R9W, WM
T1S R10W, WM
T2S R8W, WM
T2S R9W, WM
T2S R10W, WM

TILLAMOOK COUNTY


CLAIM OF BENEFICIAL USE

UNDER

Application No. S-40642 Permit No. S-30192

City of Tillamook

JANUARY 17, 2014
SCALE: 1" = 2640'

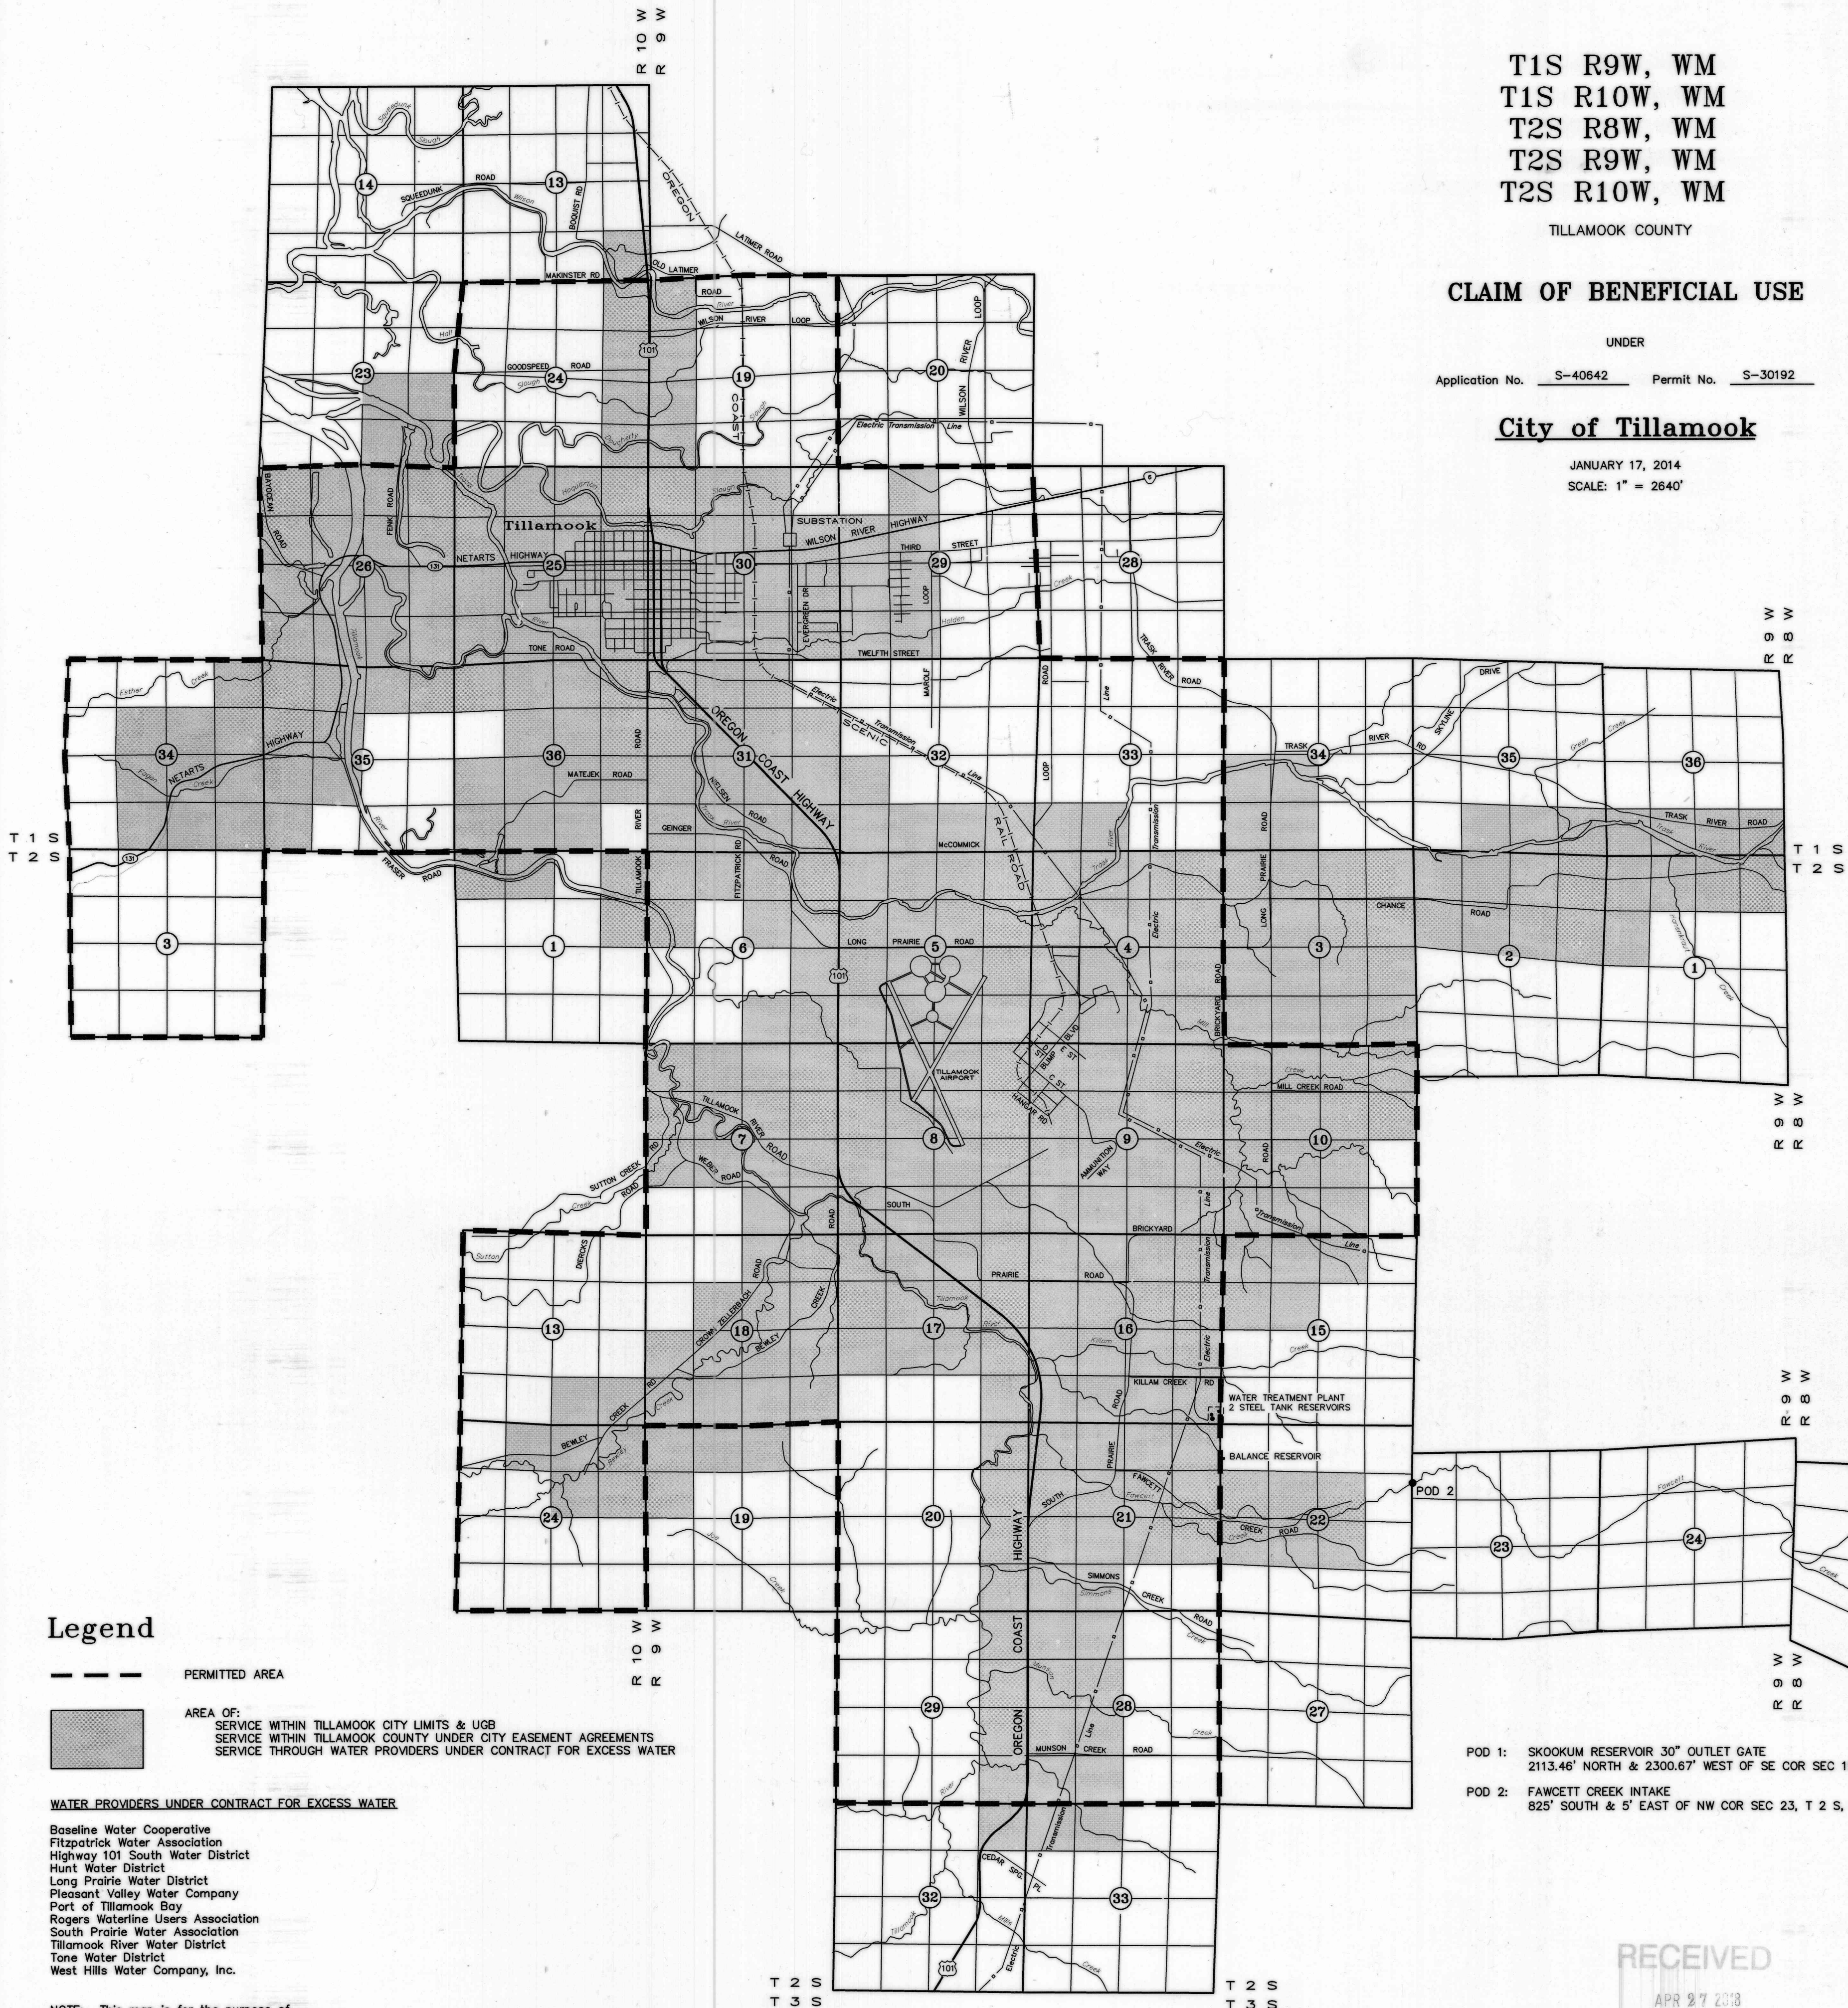

Legend

--- PERMITTED AREA

AREA OF:
SERVICE WITHIN TILLAMOOK CITY LIMITS & USB
SERVICE WITHIN TILLAMOOK COUNTY UNDER CITY EASEMENT AGREEMENTS
SERVICE THROUGH WATER PROVIDERS UNDER CONTRACT FOR EXCESS WATER

WATER PROVIDERS UNDER CONTRACT FOR EXCESS WATER

Baseline Water Cooperative
Fitzpatrick Water Association
Highway 101 South Water District
Hunt Water District
Long Prairie Water District
Pleasant Valley Water Company
Port of Tillamook Bay
Rogers Waterline Users Association
South Prairie Water Association
Tillamook River Water District
Tone Water District
West Hills Water Company, Inc.

NOTE: This map is for the purpose of identifying the location of water rights and has no intent to dimension or locate property ownership lines.

POD 1: SKOOKUM RESERVOIR 30" OUTLET GATE
2113.46' NORTH & 2300.67' WEST OF SE COR SEC 19, T 2 S, R 8 W, WM
POD 2: FAWCETT CREEK INTAKE
825' SOUTH & 5' EAST OF NW COR SEC 23, T 2 S, R 9 W, WM

RECEIVED

APR 27 2013

OWRD



RENEWAL DATE: 12-31-2019

COBU MAP# 1134