


T.6S., R.3W., W.M.

RECEIVED

MAR 3 1994

**WATER RESOURCES DEPT.
SALEM, OREGON**

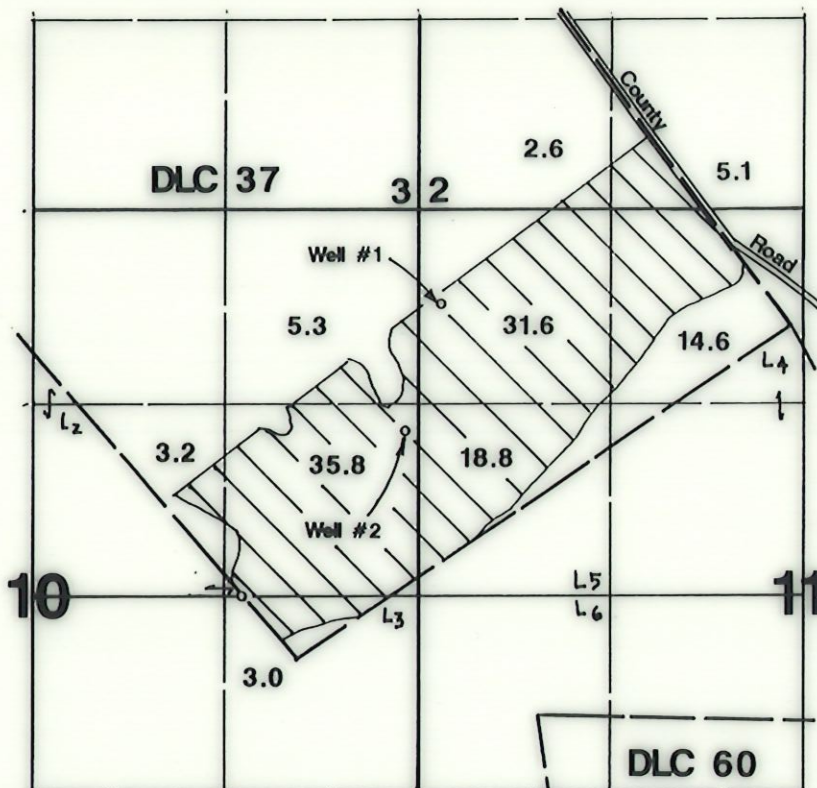

1" = 1320'



Area Irrigated

Well #1 located 2000'N & 1380'E from SE corner Lot 2, Section 10.
Well #2 located 1120'N & 1135'E from SE corner Lot 2, Section 10.


Final Proof Survey

Application #: G-12082 Permit #: G-11579

In Name Of

P.K. Farms

Surveyed on February 15, 1994 by JM Schuette

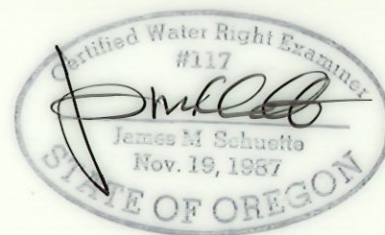

**THIS MAP WAS PREPARED FOR THE PURPOSE OF
IDENTIFYING THE LOCATION OF A WATER RIGHT
ONLY AND IS NOT INTENDED TO PROVIDE LEGAL
DIMENSIONS OR LOCATION OF PROPERTY
OWNERSHIP LINES.**