
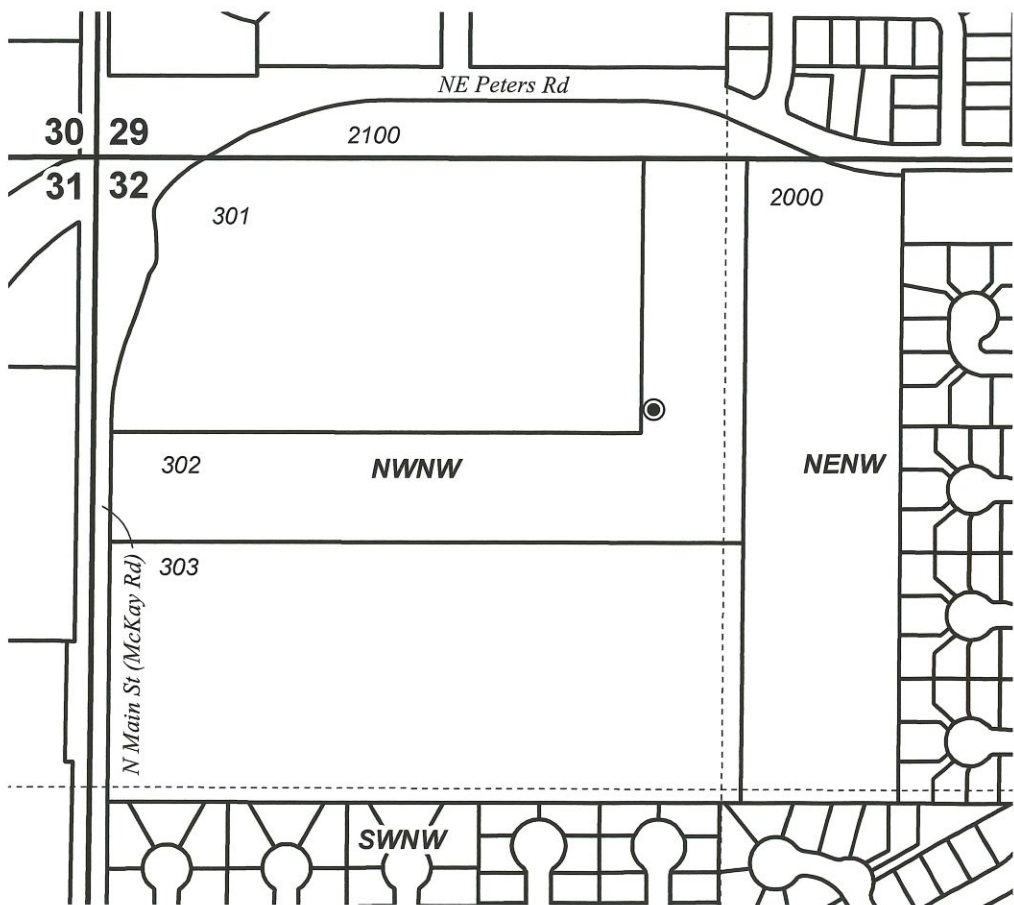


- Well & Meter
- Section
- Quarter Quarter
- Tax Lot

**T14S R16E, WM
CROOK COUNTY, OR**

**East Well (CROO 1573) Location:
518.3' S, 1157.2' E of NW Cor Sec 32**

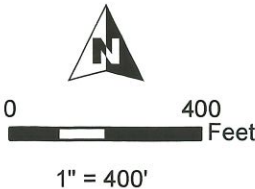

Received
DEC 11 2025
OWRD



**CLAIM OF BENEFICIAL USE MAP
W SCOTT, LLC**

Date: 10/20/2025 T-10382

This map is not intended
to provide legal dimensions
or locations of property
ownership lines.

WATER RIGHT SERVICES, LLC
PO BOX 1830, BEND, OR 97709
WWW.OREGONWATER.US CCB # 197121
johnshort@usa.com 541-389-2837