

**DAVIDBUGNI
&ASSOCIATES**

Consulting Structural Engineers

30265 S.E. Kowall Road
Estacada, OR 97023
(503) 630-3506
Fax: (503) 630-3507

CLIENT: _____


PROJECT: _____

CALCULATED BY: DB DATE: _____

CHECKED BY: _____ DATE: _____

Sheet
1 OF 1
Project No.

EXHIBIT B

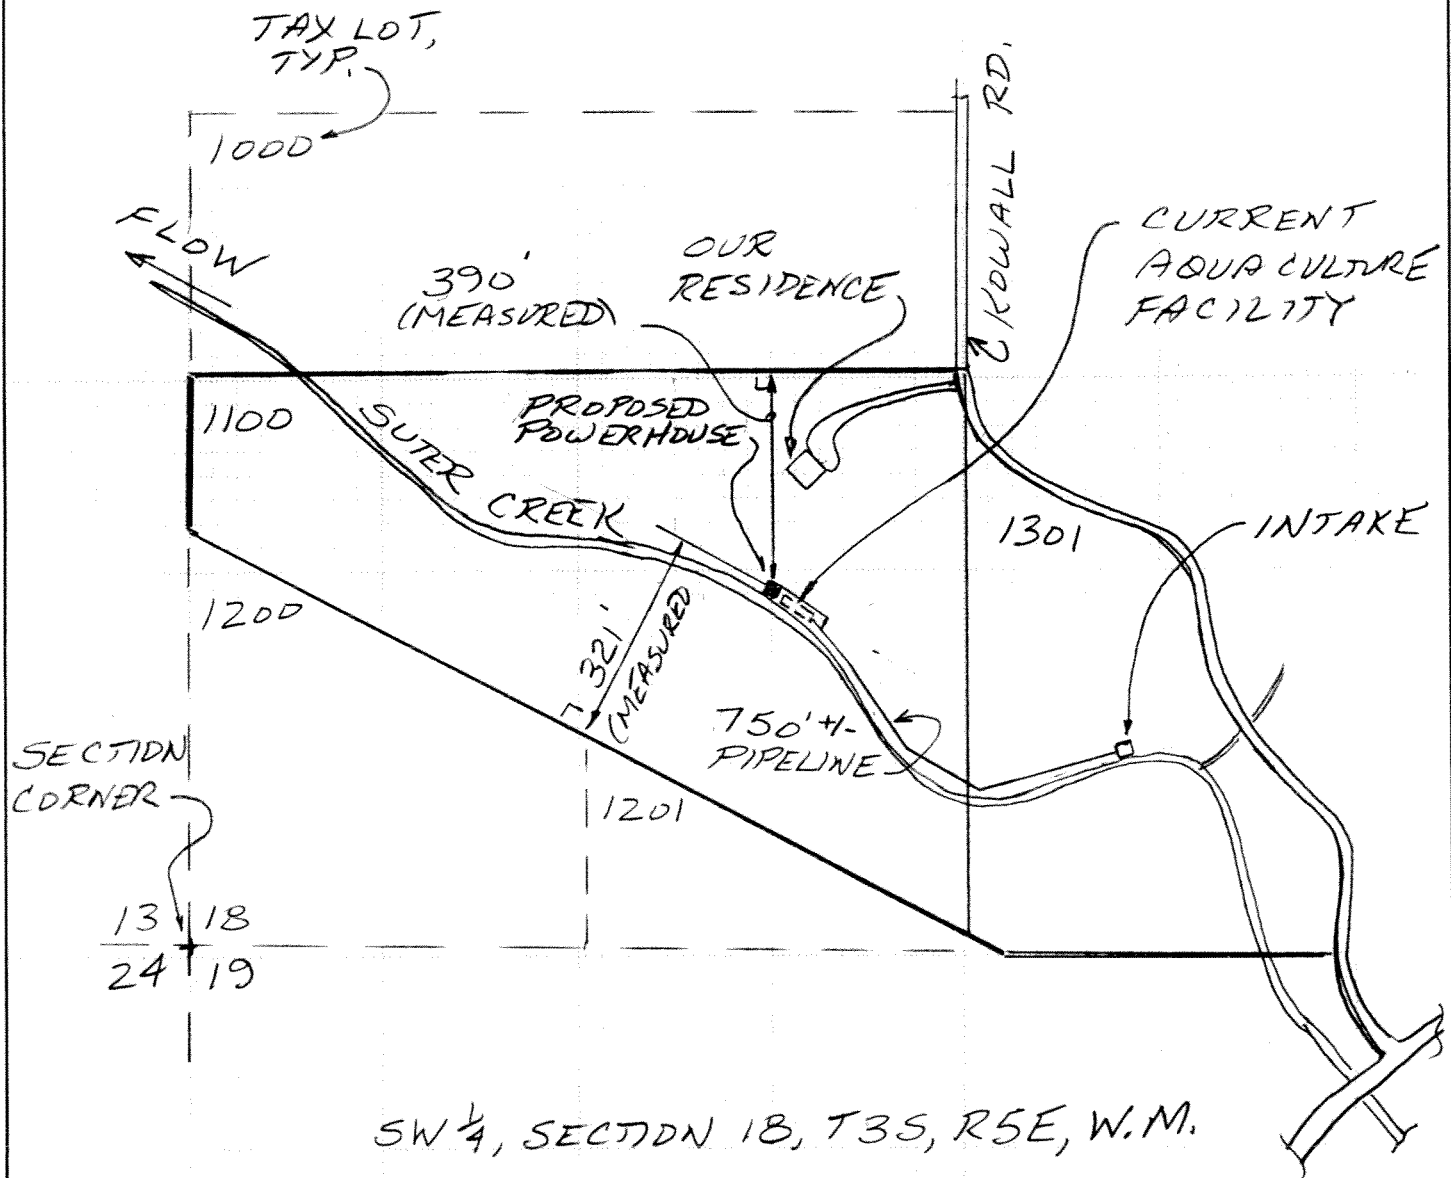

SW $\frac{1}{4}$, SECTION 18, T3S, R5E, W.M.

↑ N SITE PLAN
1" = 300'

RECEIVED

JAN 18 2007

WATER RESOURCES DEPT
SALEM OREGON

WATER RESOURCES DEPT
SALEM, OREGON

MAP #

321

FORM

1501
2.87 Ac.

MAP #