Claim of Beneficial Use

Permit S-54685, Application S-87567

A Water Right held by Bob Coleman
Columbia County

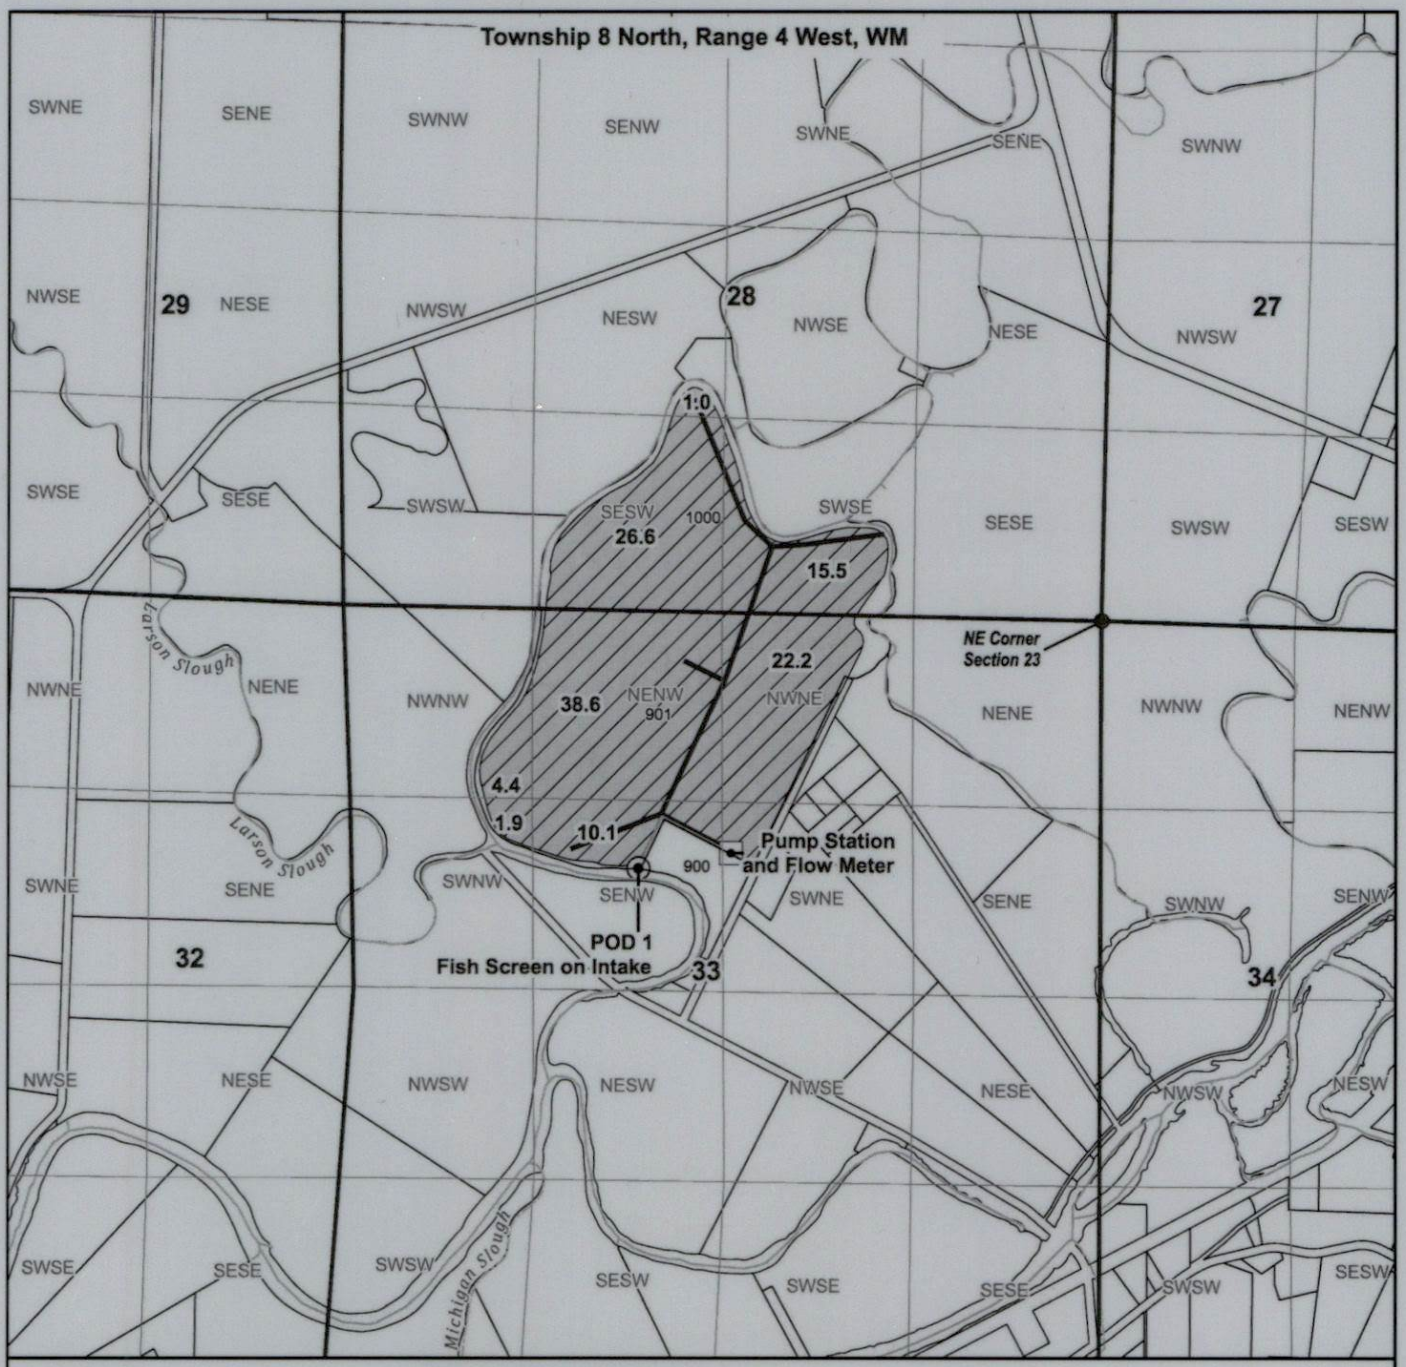

LEGEND

Point of Diversion (POD)

- POD 1
- Pump Station
- Water Mainlines
- Place of Use (POU)
- Tax Lots
- Watercourses

N

Scale

0 660 1,320 ft

1-inch = 1320 feet

POD Location Description

POD 1
Located 1745 feet South and 3190 feet West from NE corner of of Section 33 (SENW), Township 8 North, Range 4 West, W.M.

Received
JAN 02 2026
OWRD

CERTIFIED WATER RIGHT EXAMINER
78185
THEODORE R RESSLER
JUNE 29, 2007
STATE OF OREGON
RENEWS: 12-31-2026

Date: 12/15/2025
Data Sources: BLM, OWRD, ODFW, USGS, Clackamas County.
Disclaimer: This map is not intended to provide legal dimensions or property ownership lines.

summit WATER RESOURCES

Project\Coleman\0_GIS\1_SWR_Files\1_SWR_Maps\Clastkanie.qgz