

FINAL PROOF SURVEY
IN LOT 2, SECTION 27
T. 8 S.; R. 6 W.; W.M.
POLK COUNTY, OREGON
APPLICATION FILE NO. T-7359


IN THE NAME OF
**ROBIN HURT and
JAMES A. VAN GRINSVEN**

SEPTEMBER 16, 1996

NARRATIVE

The information on this plat was generated by digitizing data from the Final Proof of Survey Application No. 49737, Permit No. 37246, in name of James H. Lind & Sharie Y. Rody. The last deed call (from the Westerly line of the Adam Brown Donation Land Claim No. 46 North 33° 30' West, 13.80 chains more or less to the center of a creek) was used as control. The location of the pond and the diversion channel are based on a topographic map of the Robin Hurt property prepared by Gene Russell, Consulting Forestry dated 2/22/94.

The purpose of this map is to identify the location of a water right. It is not intended to provide information relative to the location of property ownership boundary lines.

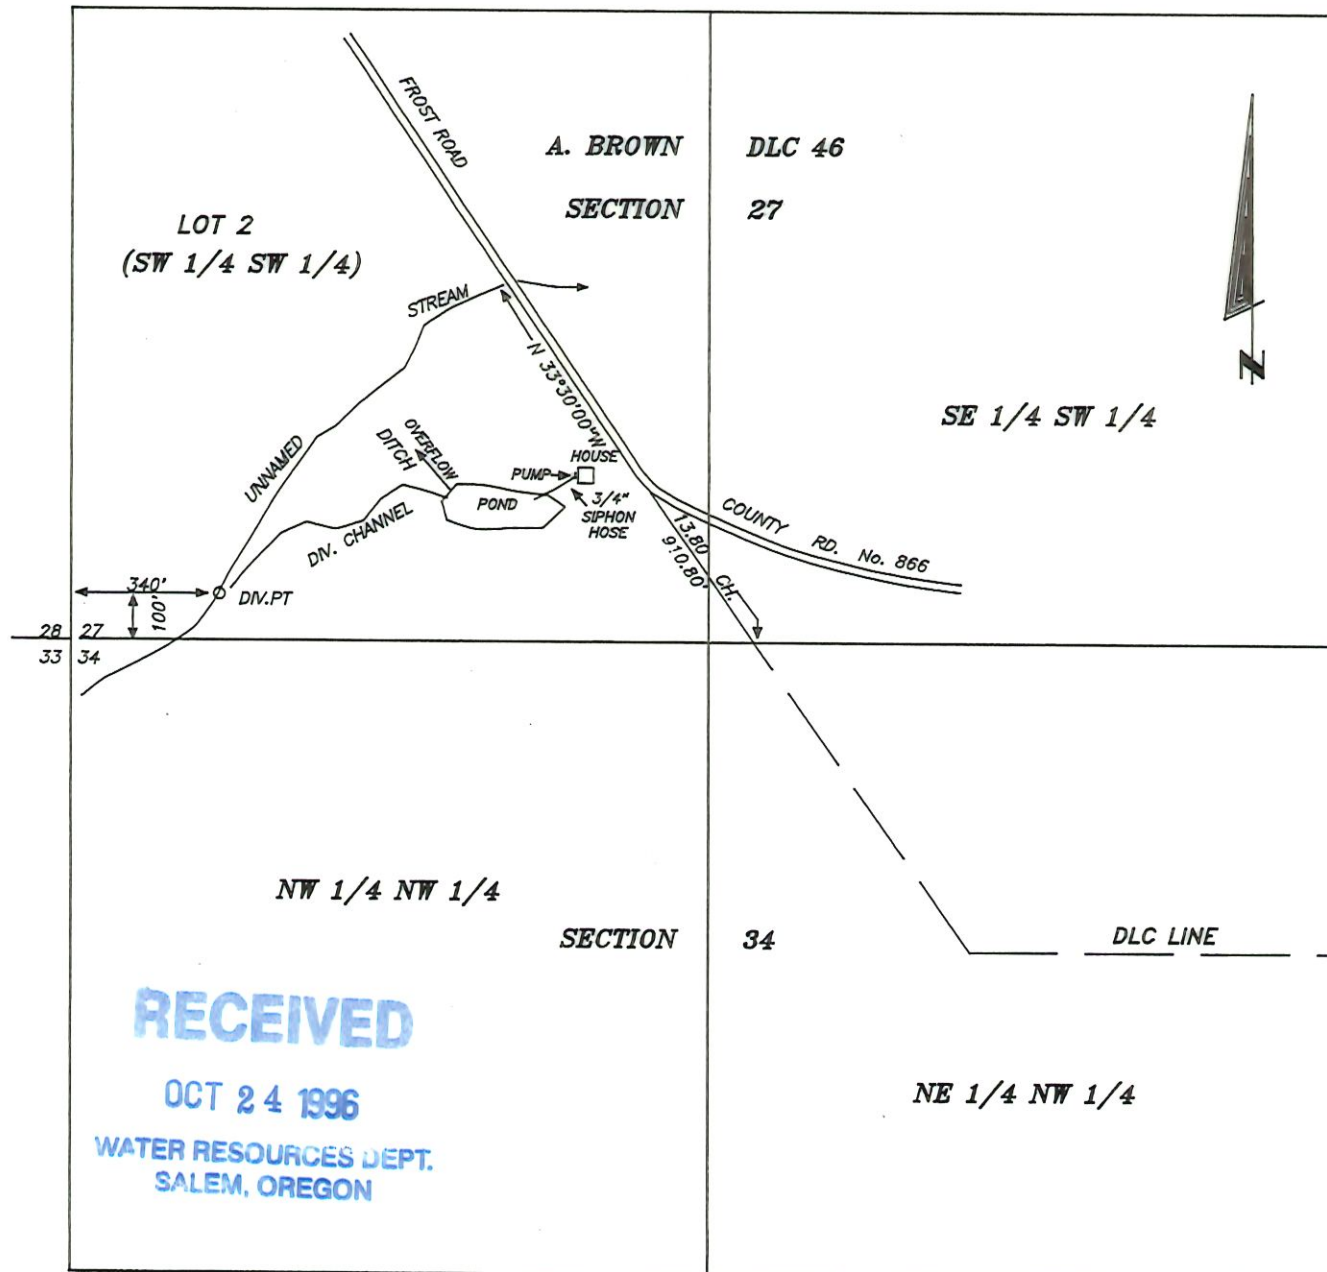

SURVEYED BY:
L. W. HUNNEMULLER
3055 N. E. LANCASTER
CORVALLIS, OR 97330
PHONE: (541) 757-7614

SCALE 1 INCH = 400 FEET