

Received by OWRD
DEC 18 2025
Salem, OR

T.19S. R.5W. Section 36, W.M.


H. Thompson
DLC 46

Center of North Pond is located 1,110 feet north
and 720 feet east from the SW corner, Section 36.

Area covered by North Pond under
T-14556 for multipurpose, formerly
Certificate 73672, priority date: 1-1-1993.

----- Tax lot boundary

----- Donation Land Claim boundary

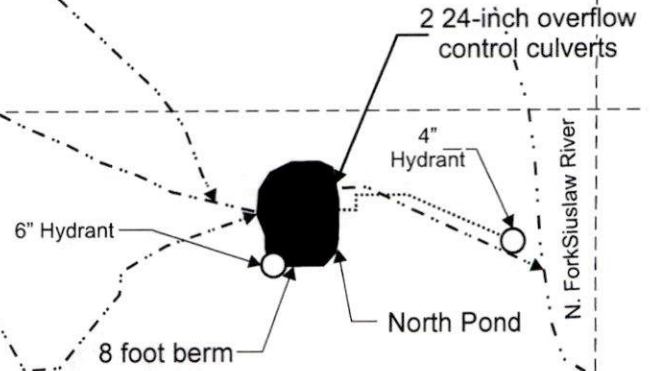

J. Thompson
DLC 47

35 36
2 1

SWSW


TL 19 5W 36 501

J. Thompson
DLC 37

M.N.Crow
DLC 38



Scale: 1" = 400'

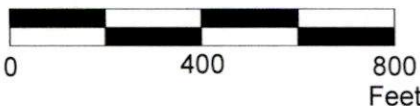

This map was prepared for the purpose of identifying the
location of a water right only and is not intended to provide legal
dimensions or location of property ownership lines.

Claim of Beneficial Use Map
T-14556, formerly Certificate 73672

Pacific Hydro-Geology Inc.

10/2025

King Estate Winery
T.19S. R.5W. Section 36, W.M.