


T.5S. R.2W. W.M.

MARION COUNTY, OREGON

RECEIVED

JUN 28 2021

OWRD

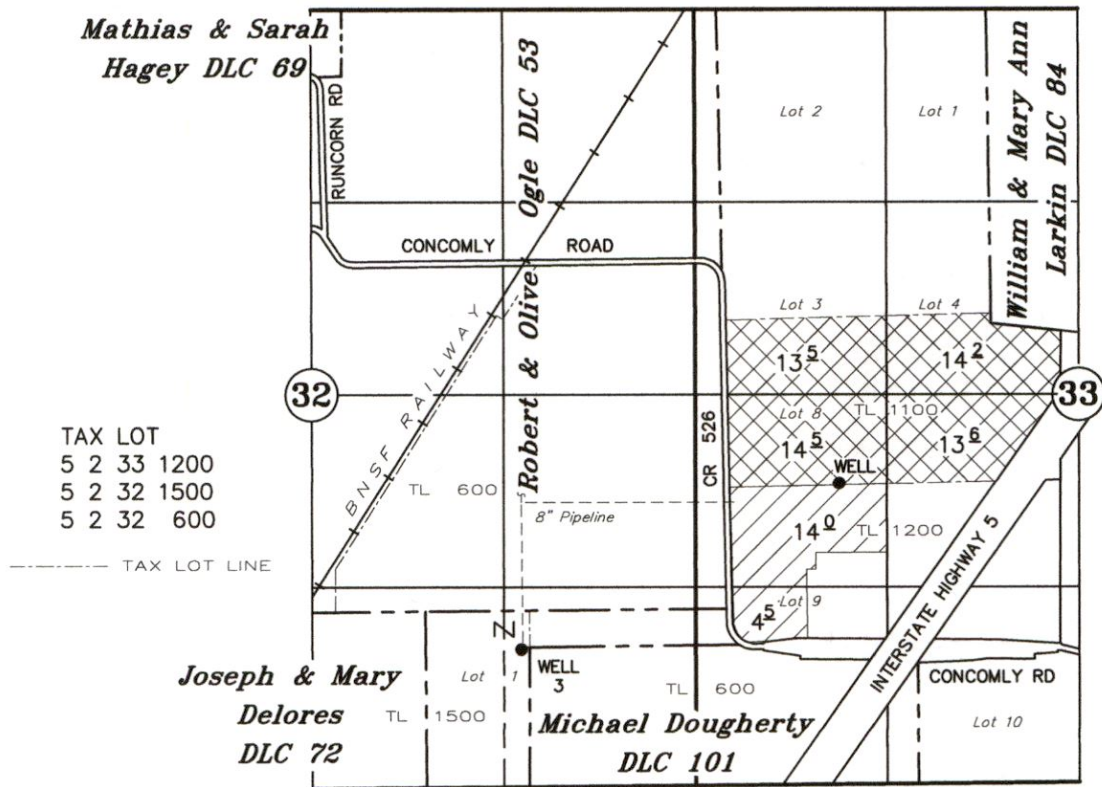

AUTHORIZED WELL: 1,090' S & 1,040' W OF SW COR LARKIN DLC No 84 (MARI 2800)

PROPOSED WELL 3: 15' S & 60' W OF NW COR DOUGHERTY DLC No 101 (MARI 2799)

(20' S & 2640' W OF NE COR DOUGHERTY DLC No 101, per Final Proof Survey Map for Permit G-3244.
Certificate 48631 for Permit G-3244, erroneously calls 2640' W from NW Cor. Dougherty DLC)



AREA TO REMAIN w/AUTHORIZED WELL



AREA TO BE SERVED w/PROPOSED WELL 3

APPLICATION TO TRANSFER A WATER RIGHT

POINT OF APPROPRIATION

CERTIFICATE No. 51040 TRANSFER No. T-

MARK McKAY

MAY 12, 2021
SCALE: 1" = 1320'


13752




NOTE: This map is for the purpose of identifying the location of water rights and has no intent to dimension or locate property ownership lines.

Renewal Date: 12-31-2021

T.5S.,R.2W.,W.M.

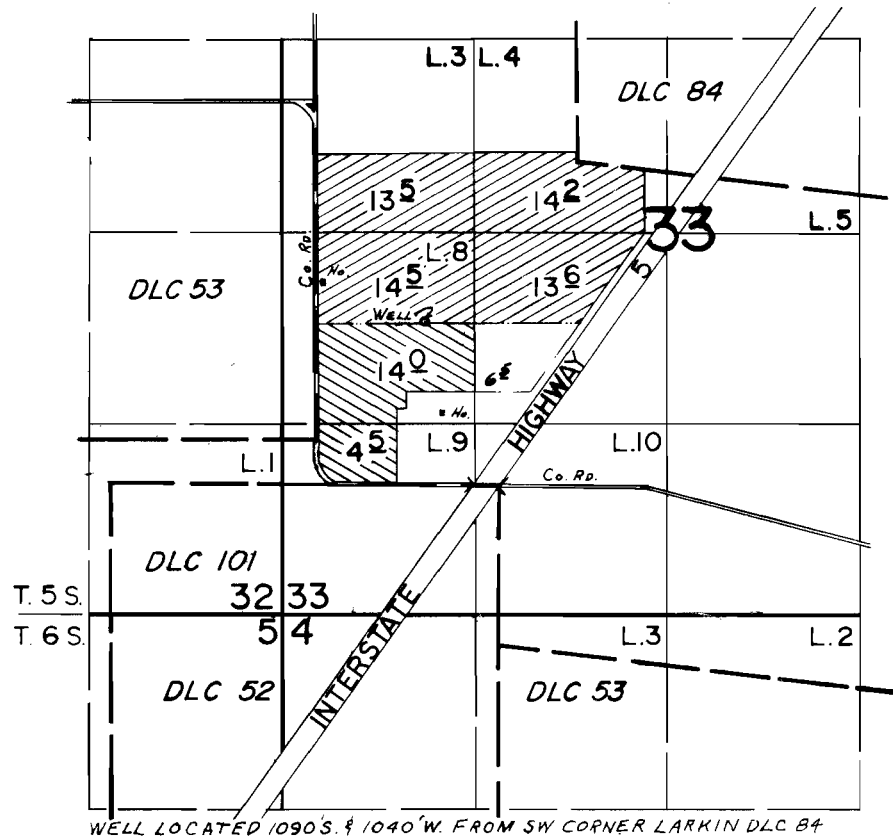

PRIORITY

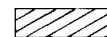

JUNE 1, 1976



JUNE 25, 1976

FINAL PROOF SURVEY
UNDER

Application No. G-7392 Permit No. G-6905
IN NAME OF

RICHARD SCHWEINFURTH

Surveyed MAY 12, 1980, by B.W. BISHOP