


Received by OWRD

FEB 16 2024

Salem, OR

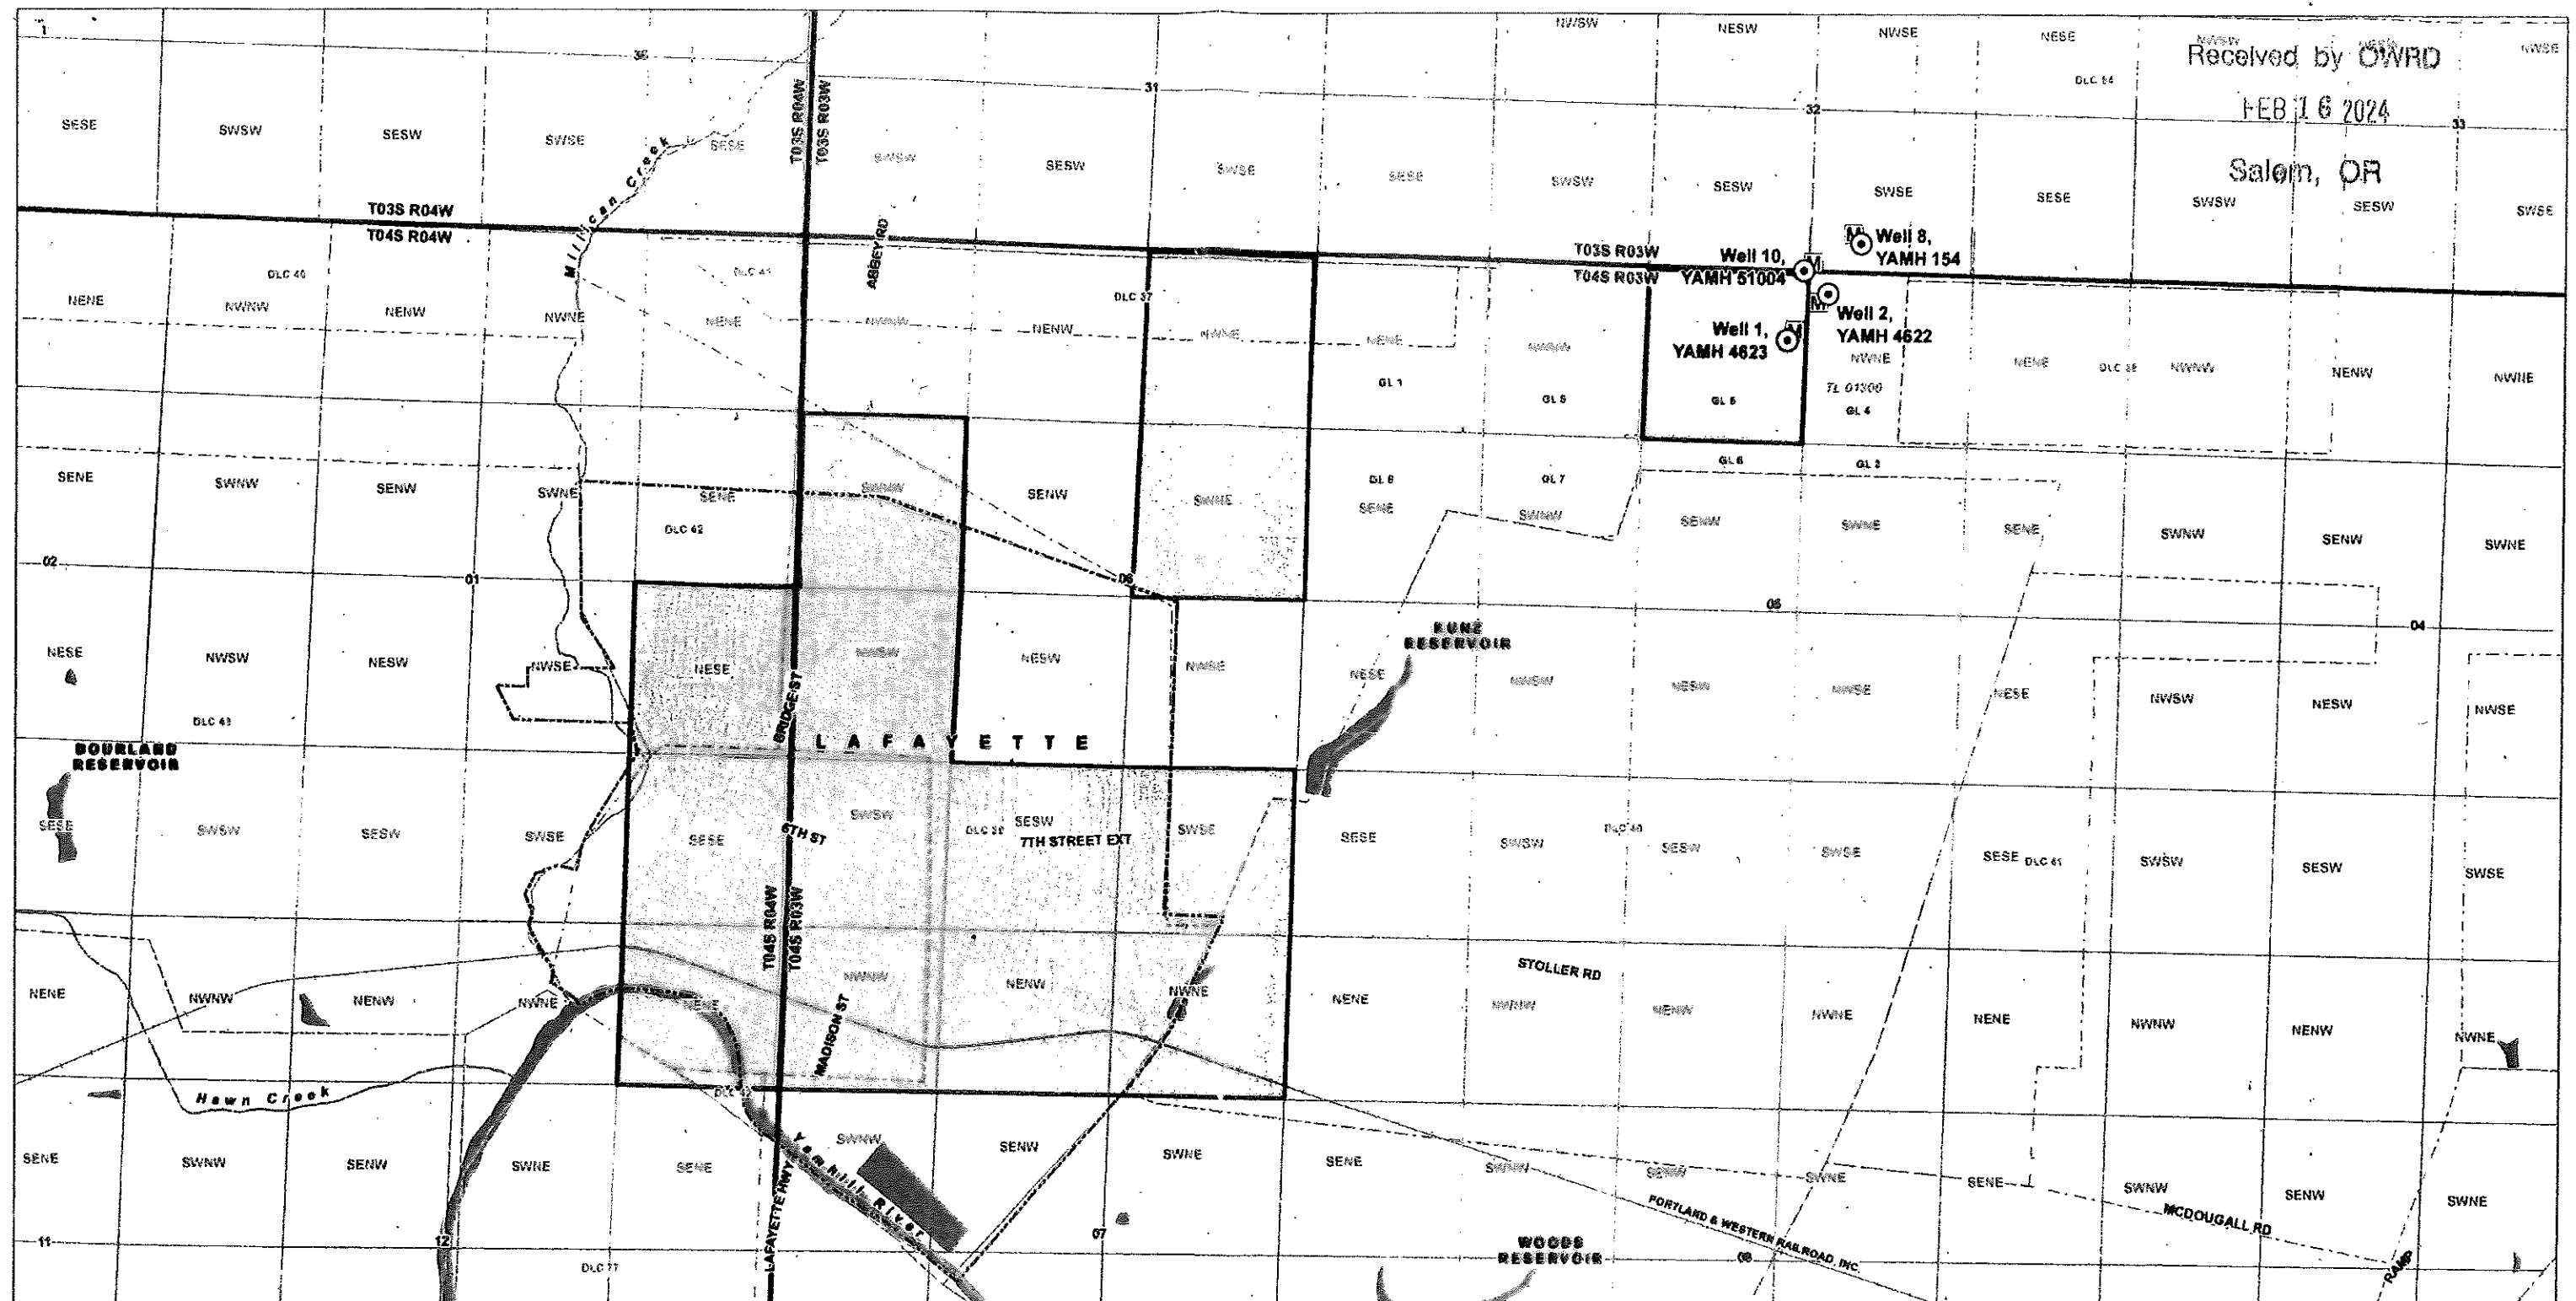

LEGEND

- ⊙ Point of Appropriation
- M Meter
- Place of Use (POU)
- City Boundary
- Tax Lot
- Donation Land Claim (DLC)
- Government Lot (GL)
- Railroad
- ~ Watercourse
- Waterbody

CERTIFIED WATER RIGHTS EXAMINER STAMP



LOCATION DESCRIPTION			
Well Name	Well Log ID	Latitude	Longitude
Well 1	YAMH 4623	45.257821	-123.083332
Well 2	YAMH 4622	45.258868	-123.082102
Well 8	YAMH 154	45.259982	-123.08112
Well 10	YAMH 51004	45.259356	-123.08289

DISCLAIMER
This map was prepared for the purpose of identifying the location of a water right only and it is not intended to provide legal dimensions or location of property ownership lines
Date January 23, 2024
Data Sources BLM ESRI, OWRD, USGS

Claim of Beneficial Use Map
City of Lafayette
T-8178

Yamhill County

Township 3/4 North, Range 3/4 West (W.M.)

