



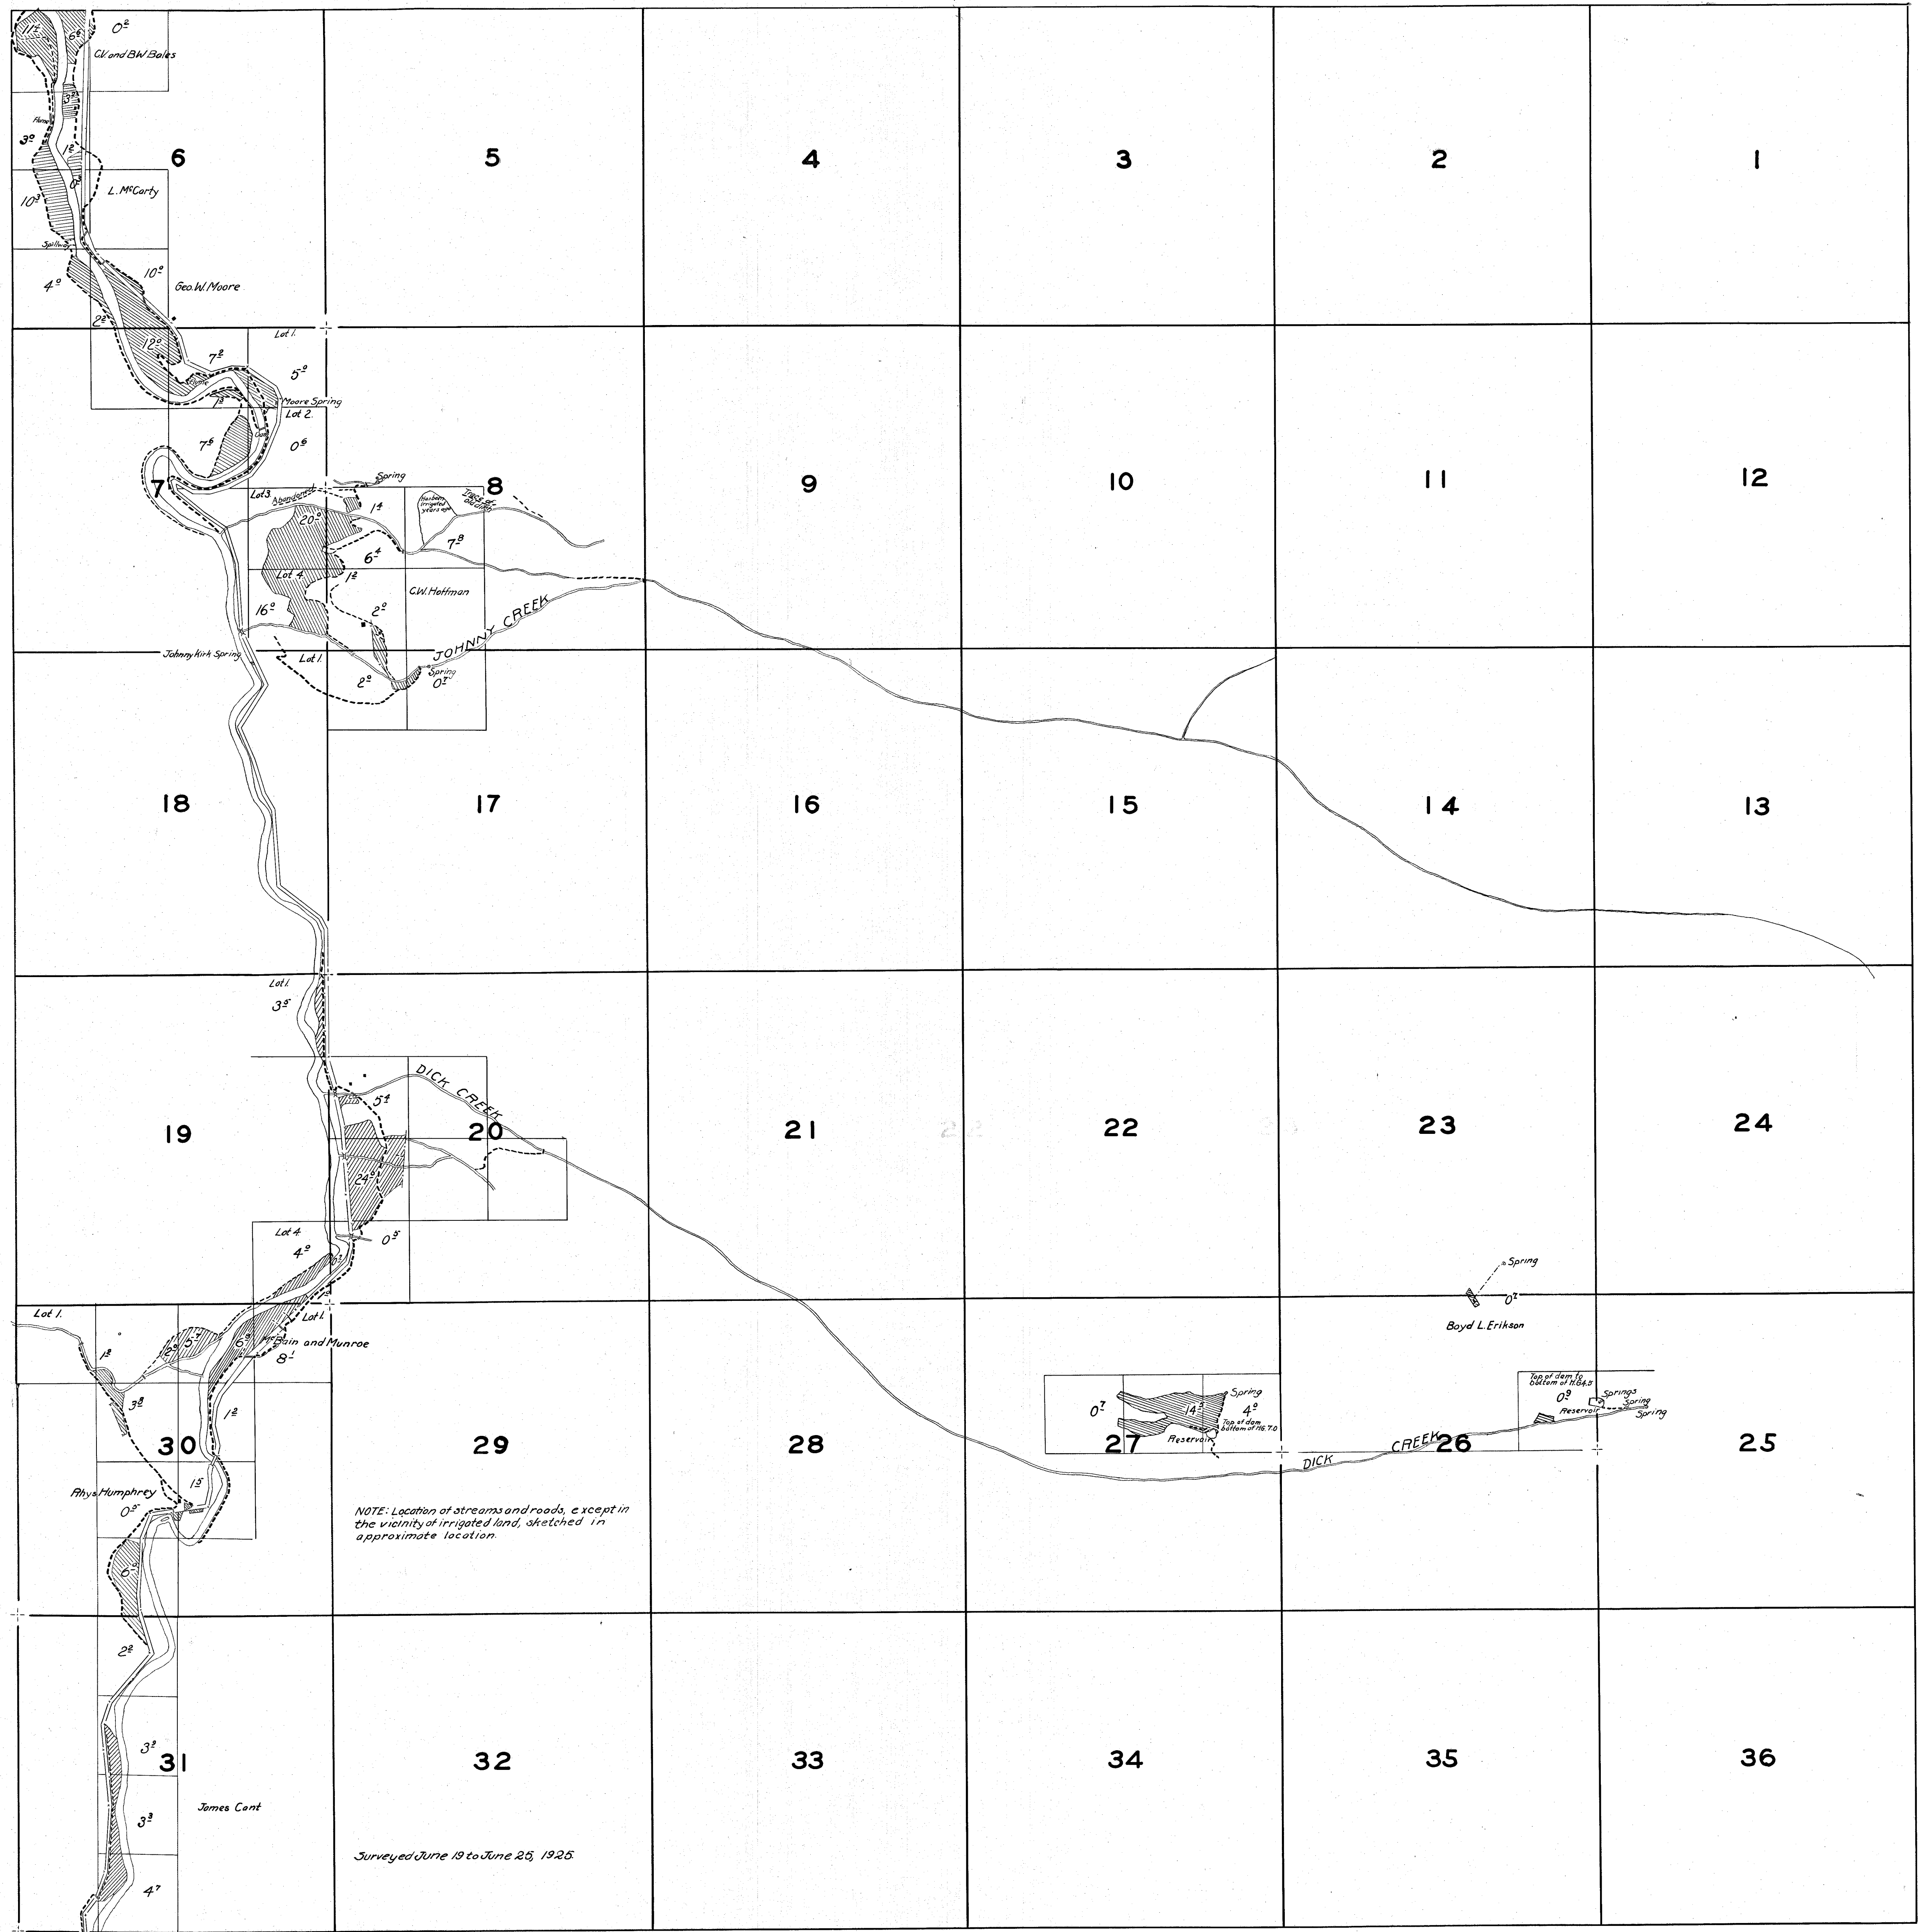

T.11S., R.26E., W.M., GRANT COUNTY, OREGON
TRANSFER APPLICATION MAP TO CHANGE IN PLACE OF USE
FOR
DRISCOLL AND GEARIN FAMILY TRUST

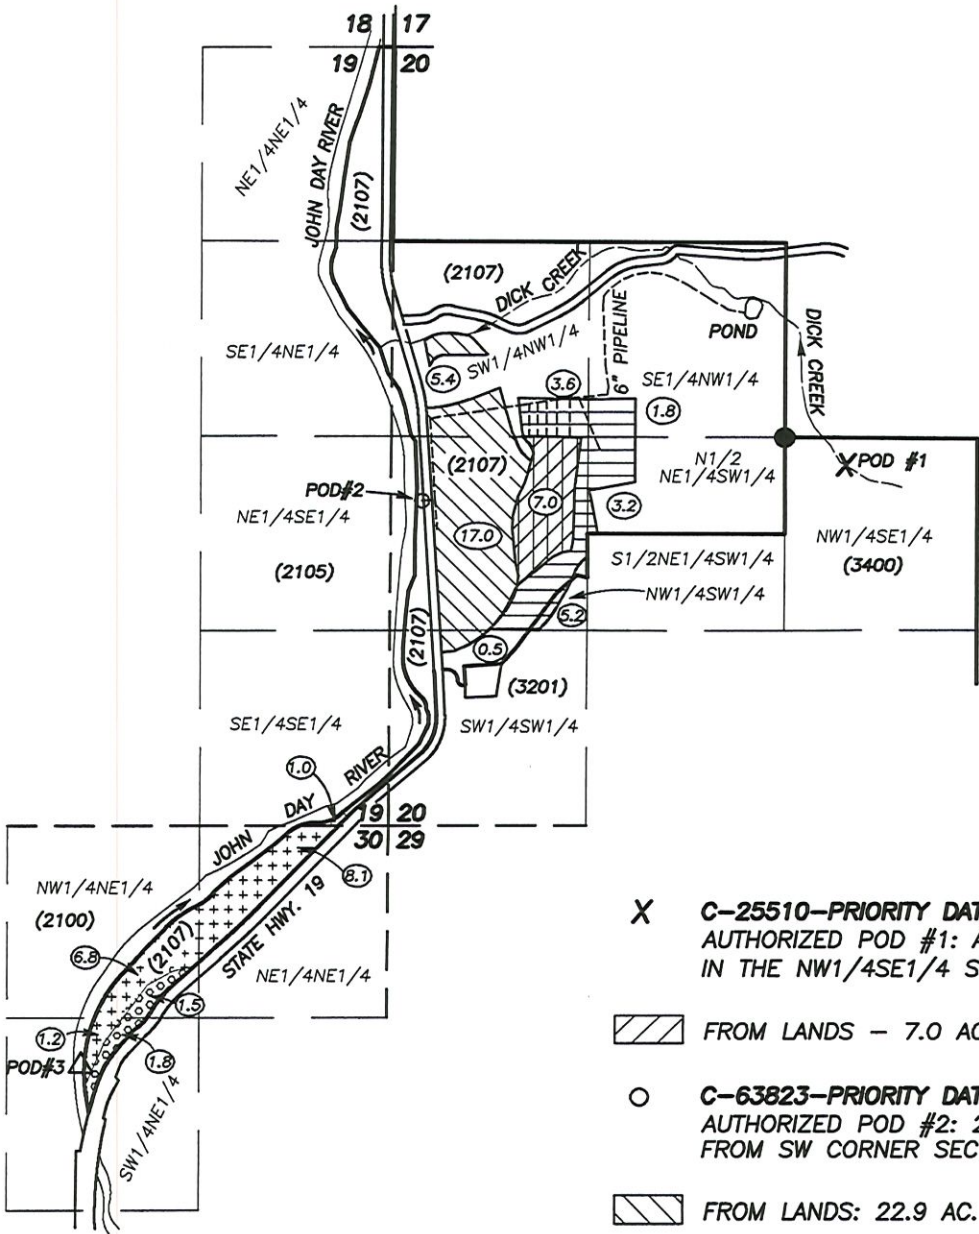

SCALE: 1" = 1320'

Received
DEC 02 2024
OWRD

X C-25510-PRIORITY DATE: 1896
AUTHORIZED POD #1: ADJUDICATION MAP PLACES POD #1
IN THE NW1/4SE1/4 SECTION 20, T.11S., R.26E.,

FROM LANDS - 7.0 AC.

O C-63823-PRIORITY DATE: 1883
AUTHORIZED POD #2: 2350 FT. NORTH & 190 FT. EAST
FROM SW CORNER SECTION 20, T.11S., R.26E.

FROM LANDS: 22.9 AC.

△ AUTHORIZED POD #3: 1650 FT. SOUTH & 2100 FT. WEST
FROM SW CORNER SECTION 20, T.11S., R.26E.

REMAING RIGHT: 17.1 AC.

O C-82384-PRIORITY DATE: 1981
AUTHORIZED POD #2: 2350 FT. NORTH & 190 FT. EAST
FROM SW CORNER SECTION 20, T.11S., R.26E.

FROM LANDS (PRIMARY): 13.8 AC.

FROM LANDS (SUPPLEMENTAL): 7.0 AC.

△ AUTHORIZED POD #3: 1650 FT. SOUTH & 2100 FT. WEST
FROM SW CORNER SECTION 20, T.11S., R.26E.

REMAING RIGHT: 3.3 AC.

PIPELINE


() TAX LOT NO.

● FOUND ALUMINUM CAP MONUMENT AT C1/4 CORNER SECTION 20,
T.11S., R.26E.

PREPARED BY:

ROBERT D. BAGETT, PLS, CWRE
217 N. CANYON BLVD.
JOHN DAY, OREGON
(541) 575-1251

OCTOBER 28, 2024

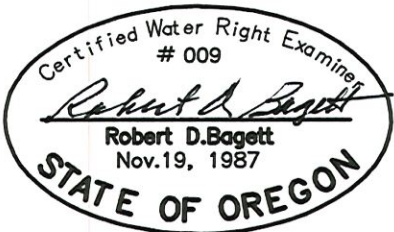

RENEWS 12/31/2025