


Township 11 S., Range 26 E., W.M.

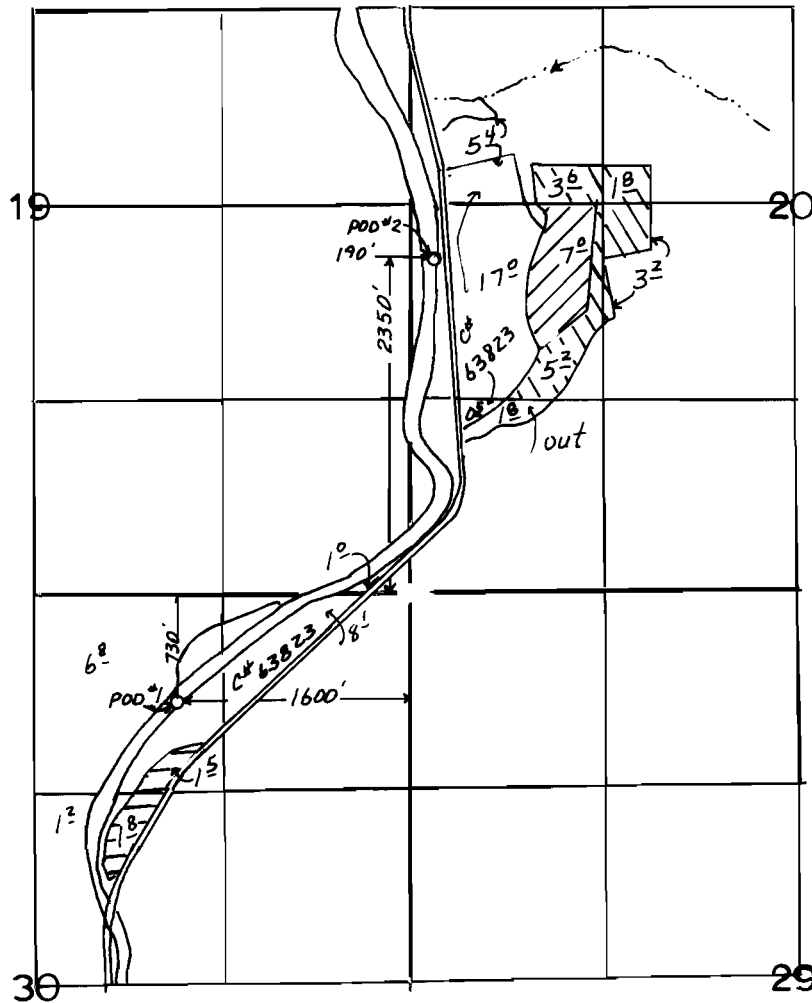

POD 1



POD 2 PRIMARY



POD 2 SUPPL'
TO C# 25510


FINAL PROOF SURVEY UNDER

Application No. 616Q1... Permit No. 45796.....
IN NAME OF

.....MICHAL & ELISABETH H. WISCAVAGE.....

Surveyed Sept. 8... 19.99., by J. Miller.....

T.11S., R.26E., W.M., GRANT COUNTY, OREGON
TRANSFER APPLICATION MAP TO CHANGE IN PLACE OF USE
FOR
DRISCOLL AND GEARIN FAMILY TRUST

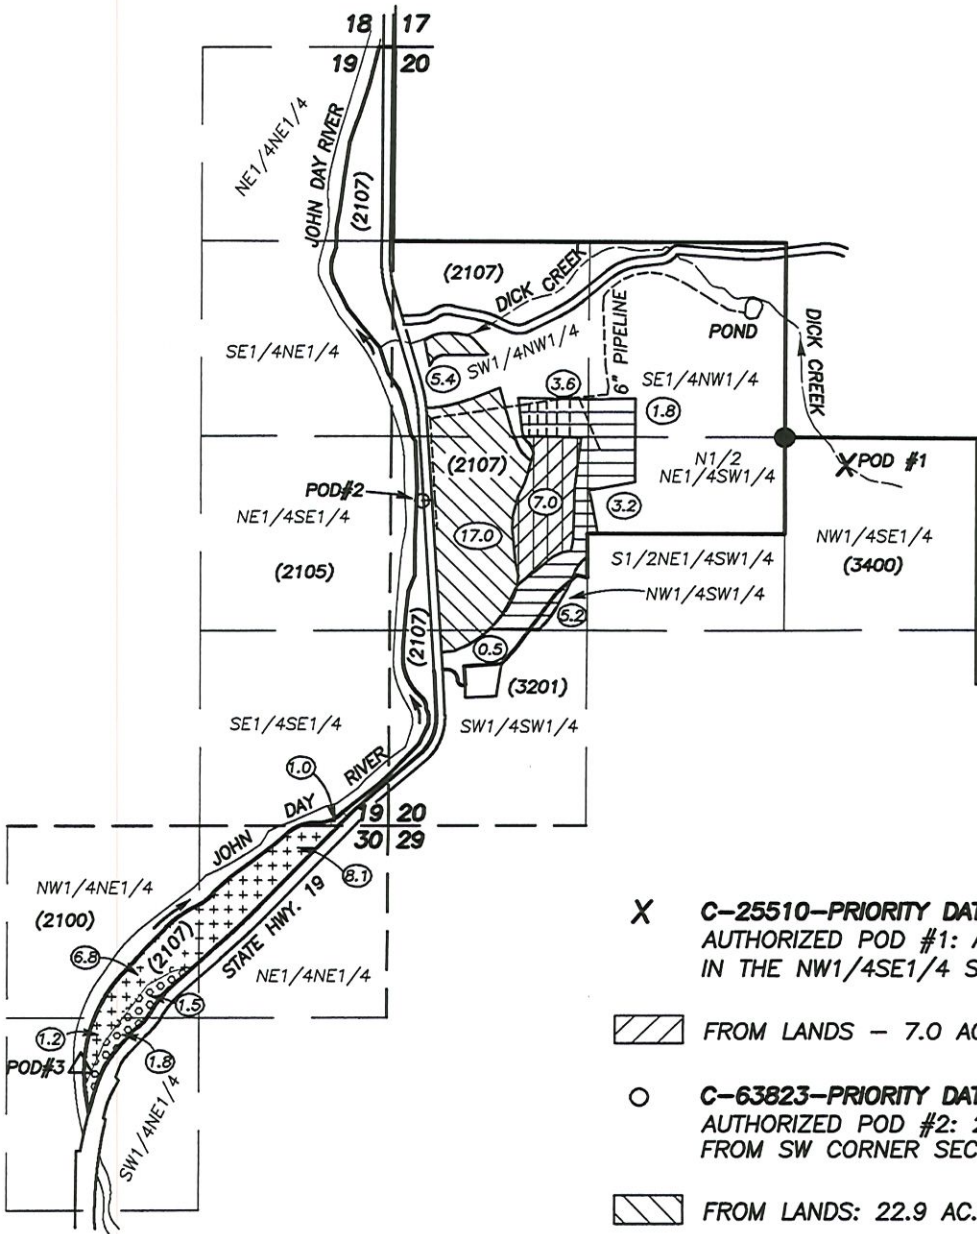

SCALE: 1" = 1320'

Received
DEC 02 2024
OWRD

X C-25510-PRIORITY DATE: 1896
AUTHORIZED POD #1: ADJUDICATION MAP PLACES POD #1
IN THE NW1/4SE1/4 SECTION 20, T.11S., R.26E.,

FROM LANDS - 7.0 AC.

O C-63823-PRIORITY DATE: 1883
AUTHORIZED POD #2: 2350 FT. NORTH & 190 FT. EAST
FROM SW CORNER SECTION 20, T.11S., R.26E.

FROM LANDS: 22.9 AC.

△ AUTHORIZED POD #3: 1650 FT. SOUTH & 2100 FT. WEST
FROM SW CORNER SECTION 20, T.11S., R.26E.

REMAING RIGHT: 17.1 AC.

O C-82384-PRIORITY DATE: 1981
AUTHORIZED POD #2: 2350 FT. NORTH & 190 FT. EAST
FROM SW CORNER SECTION 20, T.11S., R.26E.

FROM LANDS (PRIMARY): 13.8 AC.

FROM LANDS (SUPPLEMENTAL): 7.0 AC.

△ AUTHORIZED POD #3: 1650 FT. SOUTH & 2100 FT. WEST
FROM SW CORNER SECTION 20, T.11S., R.26E.

REMAING RIGHT: 3.3 AC.

PIPELINE


() TAX LOT NO.

● FOUND ALUMINUM CAP MONUMENT AT C1/4 CORNER SECTION 20,
T.11S., R.26E.

PREPARED BY:

ROBERT D. BAGETT, PLS, CWRE
217 N. CANYON BLVD.
JOHN DAY, OREGON
(541) 575-1251

OCTOBER 28, 2024

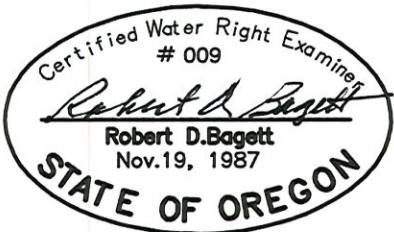

RENEWS 12/31/2025