


COBU MAP # 0221

FINAL PROOF SURVEY

UNDER APPLICATION No. G-15858 , PERMIT No. G-15819
LOCATED IN THE NORTH 1/2 OF SECTION 14, T1S, R3W, WM.
WASHINGTON COUNTY, OREGON
SURVEY DATE: SEPTEMBER 6, 2006

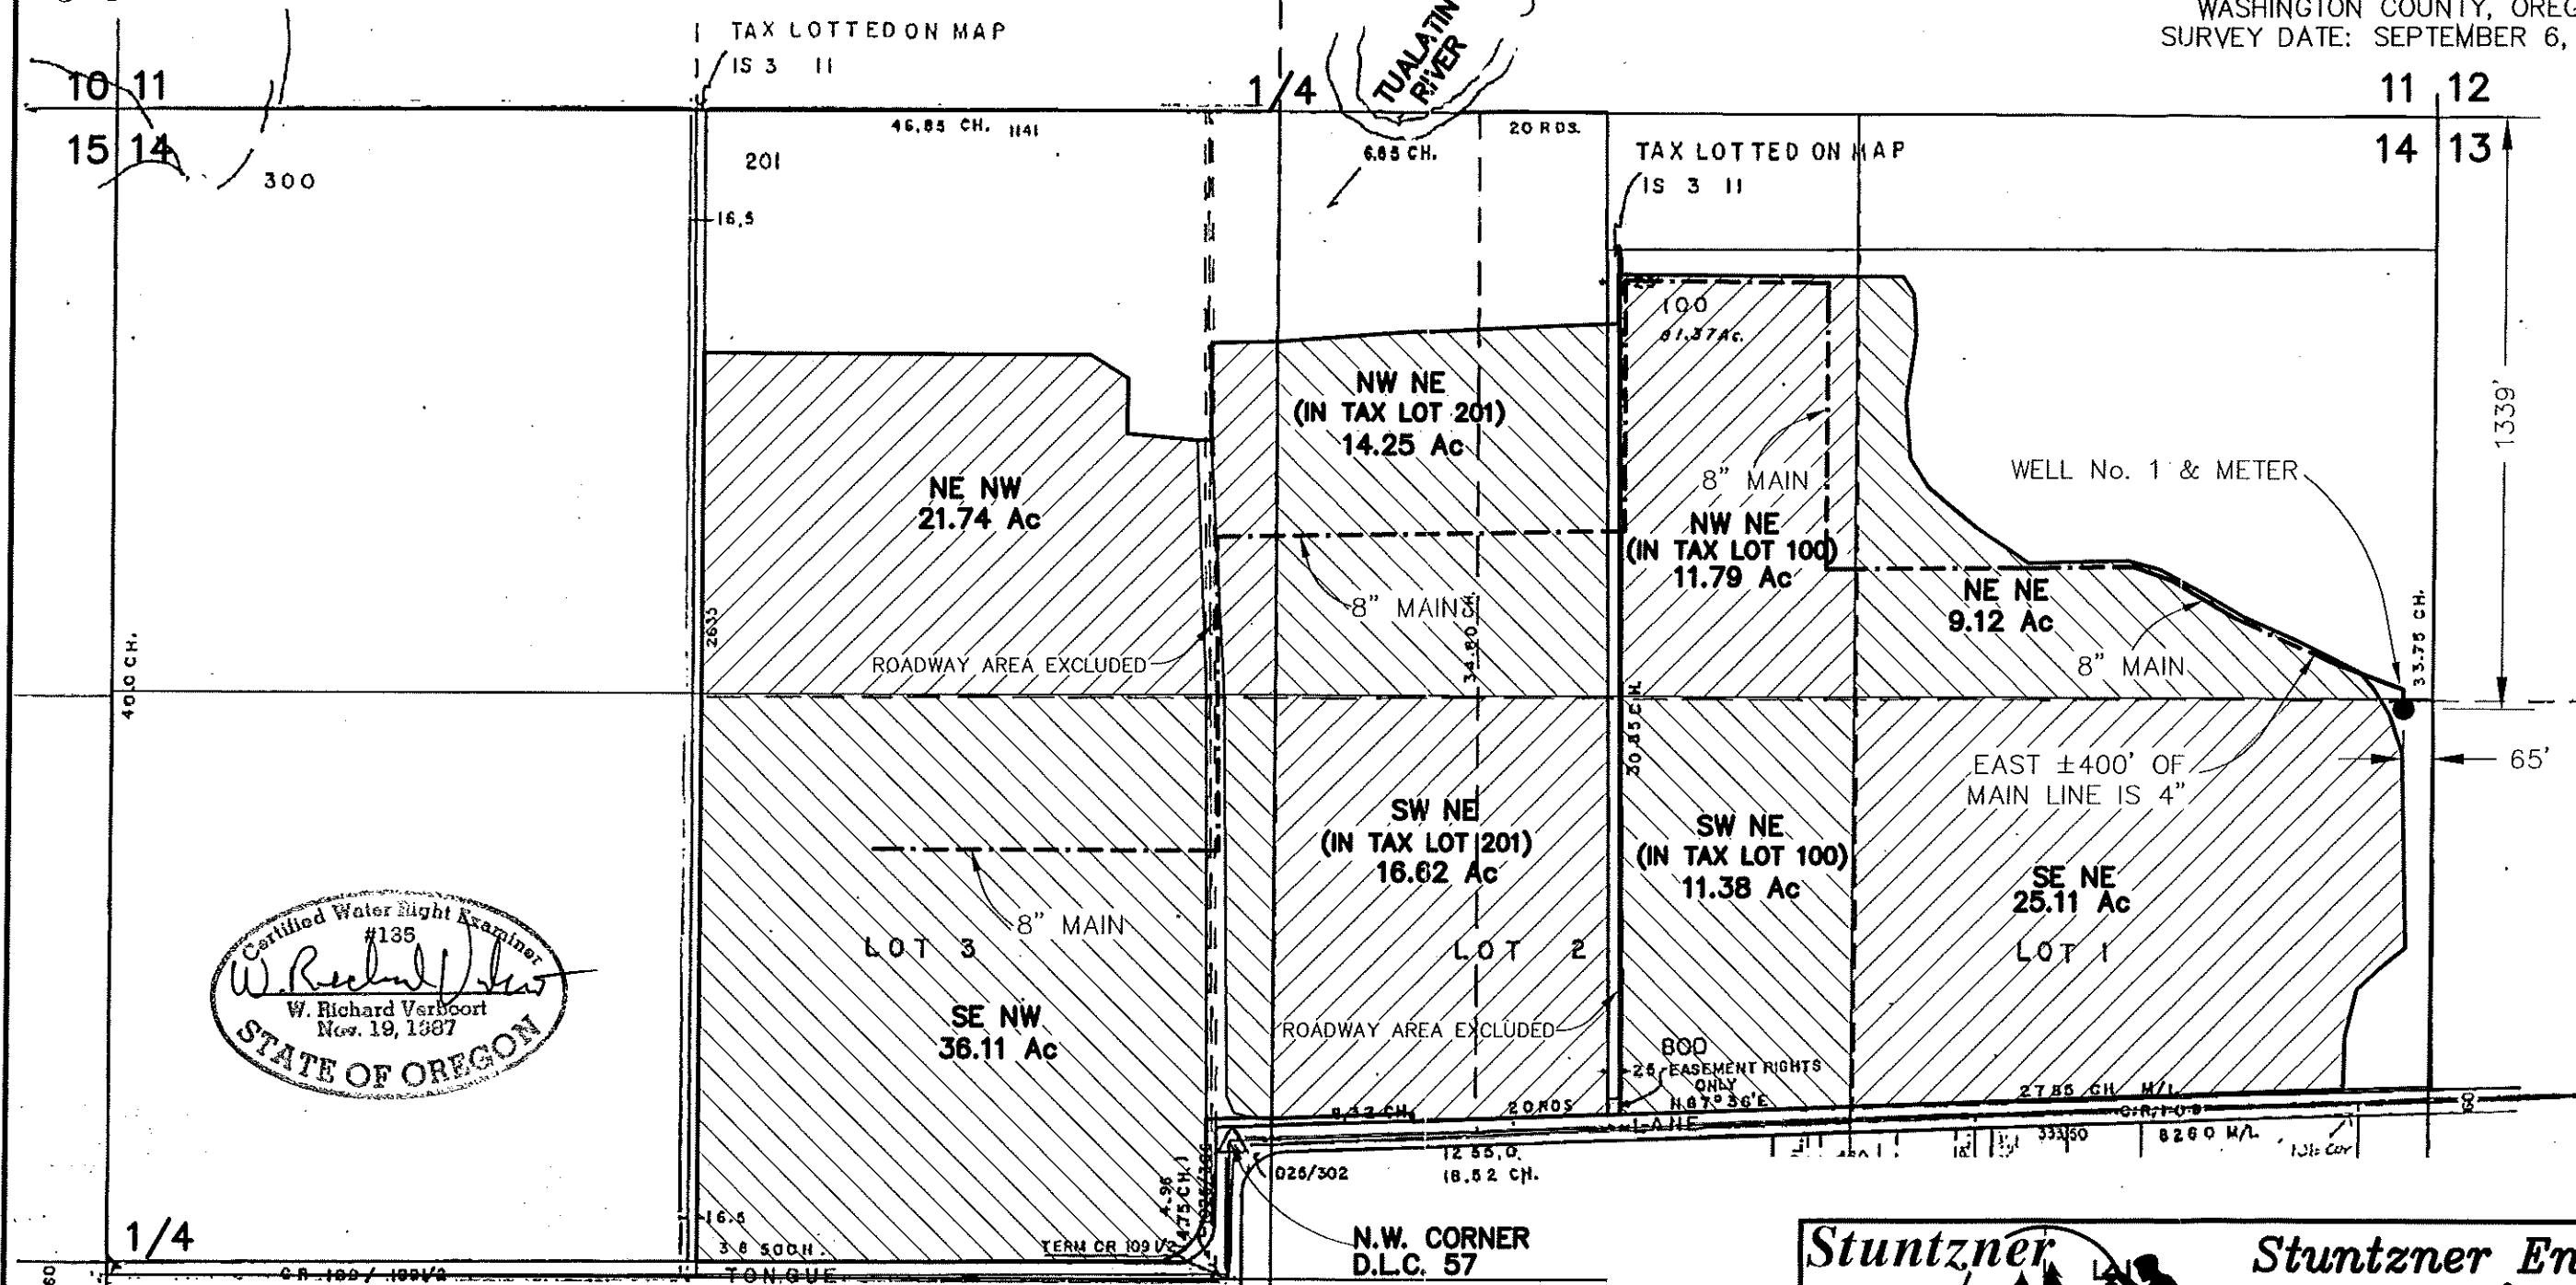


THIS MAP WAS PREPARED FOR THE PURPOSE OF IDENTIFYING THE LOCATION OF A WATER RIGHT ONLY AND IS NOT INTENDED TO PROVIDE LEGAL DIMENSIONS OR LOCATION OF PROPERTY OWNERSHIP LINES.

MAP BASE:
ASSESSOR MAP S14 T1S R3W
2006 FSA AERIAL PHOTO

RECEIVED

SEP 25 2006

WATER RESOURCES DEPT
SALEM, OREGON

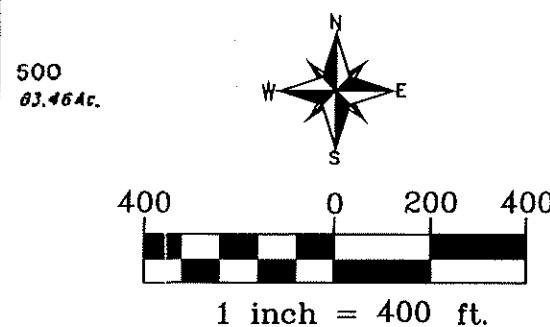

Stuntzner
Engineering
& Forestry, LLC



COOS BAY * FOREST GROVE * BROOK

***Stuntzner Engineering
&
Forestry, LLC***
ENGINEERING * LAND SURVEYING * FORESTRY
PLANNING * WATER RIGHTS

2137 19TH AVENUE
FOREST GROVE, OREGON 97116

PROJECT: GLENN WALTERS NURSERY - BOWLBY
DRAWING No.: 3062109GWN

TEL: (503) 357-5717
FAX: (503) 357-5698
E-MAIL: INFO@STUNTZNER.COM

DATE: SEPT. 6, 2006
DRAWN BY: DON W. JONES