
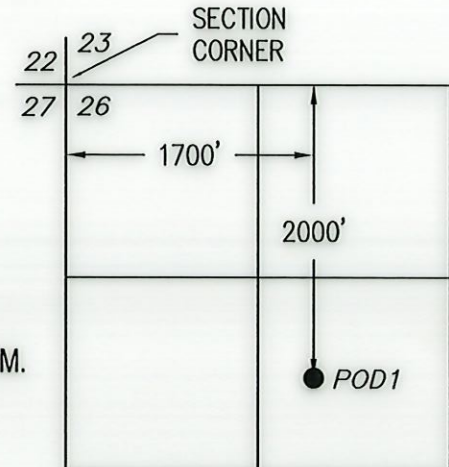


CLAIM OF BENEFICIAL USE MAP

APPLICATION: S-88644
PERMIT: S-55204 - PRIORITY DATE 7/20/2018
IRRIGATION

FOR
SHARON A MATLOCK, TRUSTEE
SHARON A MATLOCK TRUST
PO BOX 925
SHADY COVE, OR 97539



SITUATED IN
SECTION 15, TOWNSHIP 34 SOUTH, RANGE 1 WEST, W.M.
JACKSON COUNTY, OREGON

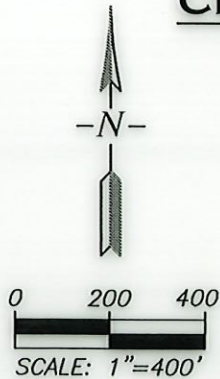

LOST CREEK RESERVOIR
POINT OF DIVERSION
T.33S., R.1E., W.M.
SCALE: 1"=1320'

This map is not intended to
provide legal dimensions or
locations of property
ownership lines.

EHM-June 6, 2020
ROGUE CIVIL LLC
emalepsy@roguecivil.com 541-621-2868

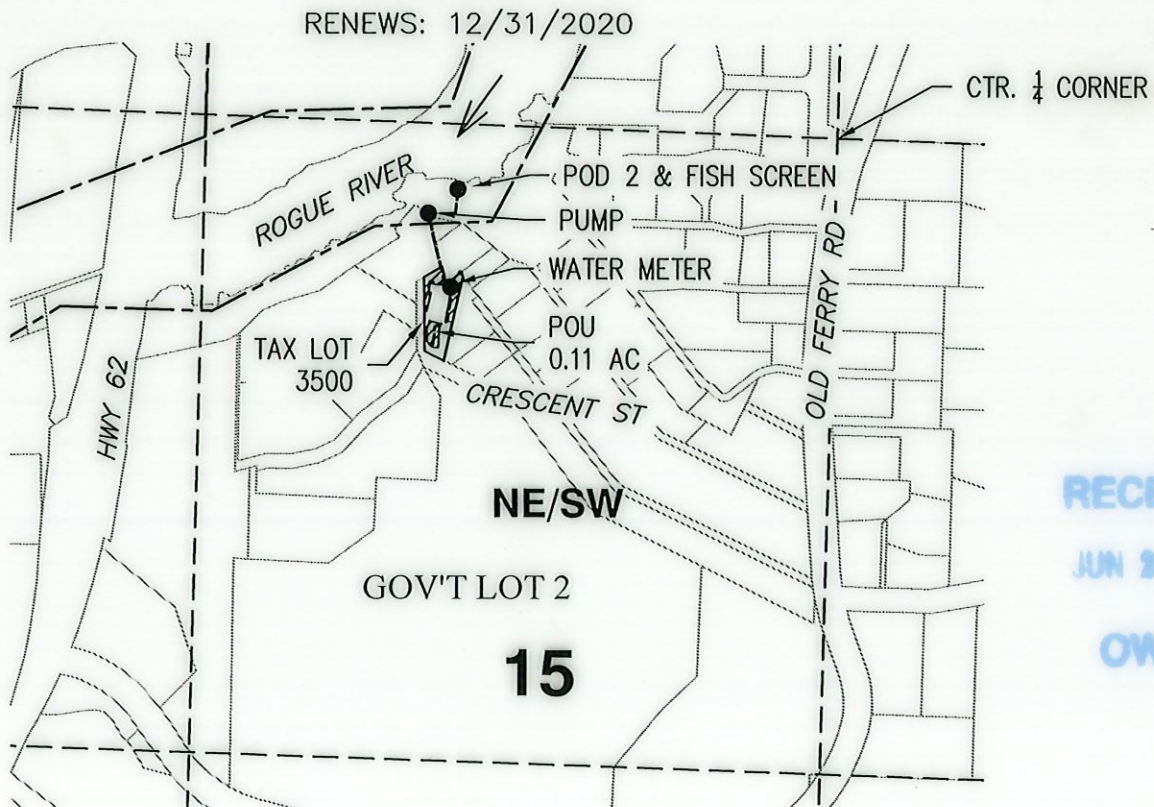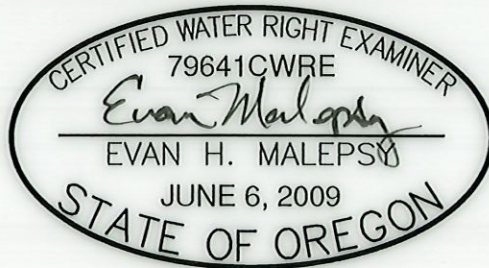

RECEIVED
JUN 9 2020
OWRD

LEGEND

- **POD 2**
POINT OF RE-DIVERSION AND FISH
SCREEN.
107' SOUTH AND 792' WEST FROM
C1/4 CORNER, SECTION 15.

- PLACE OF USE-IRRIGATION
- 1/4-1/4 SECTION LINE
- GOVERNMENT LOT BOUNDARY
- BURIED WATERLINE (APPROXIMATE)