

Township 4 North, Range 28 East, W.M.
Sections 19 & 30
UMATILLA COUNTY



LEGEND

SYMBOLS

- SECTION LINES
- - - Q-Q SECTION LINES
- TAX LOTS
- IRRIGATION CANAL
- ||||| RAILROAD
- PLANT BUILDINGS
- BURIED PIPELINES
- WELLS

NOTE: FLOW METERS ARE
LOCATED AT WELLS.

N

SCALE
1" = 1320'

POINTS OF APPROPRIATION

AUTHORIZED:

WELL #2 - 1680' N & 1640' E FROM SW COR. OF SEC. 19

ADDITIONAL:

WELL #1 - 2430' N & 2340' E FROM SW COR. OF SEC. 19

WELL #3 - 776.5' S & 2141.5' E FROM NW COR. OF SEC. 30


WATER RIGHT
COBU MAP
for Transfer T-12871
in the name of
Lamb-Weston, Inc.
February 24th, 2023

THIS MAP WAS PREPARED FOR THE PURPOSE OF
IDENTIFYING THE LOCATION OF A WATER RIGHT
ONLY AND IS NOT INTENDED TO PROVIDE LEGAL
DIMENSIONS OR LOCATION OF PROPERTY
OWNERSHIP LINES.

RECEIVED

MAR 09 2023

OWRD
SALEM, OREGON

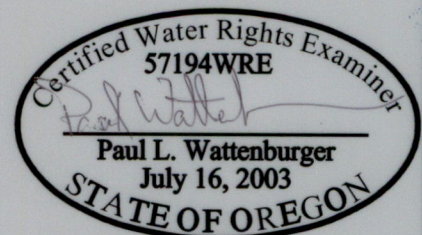

EXPIRES: 6/30/24