


Received
DEC 18 2024
OWRD

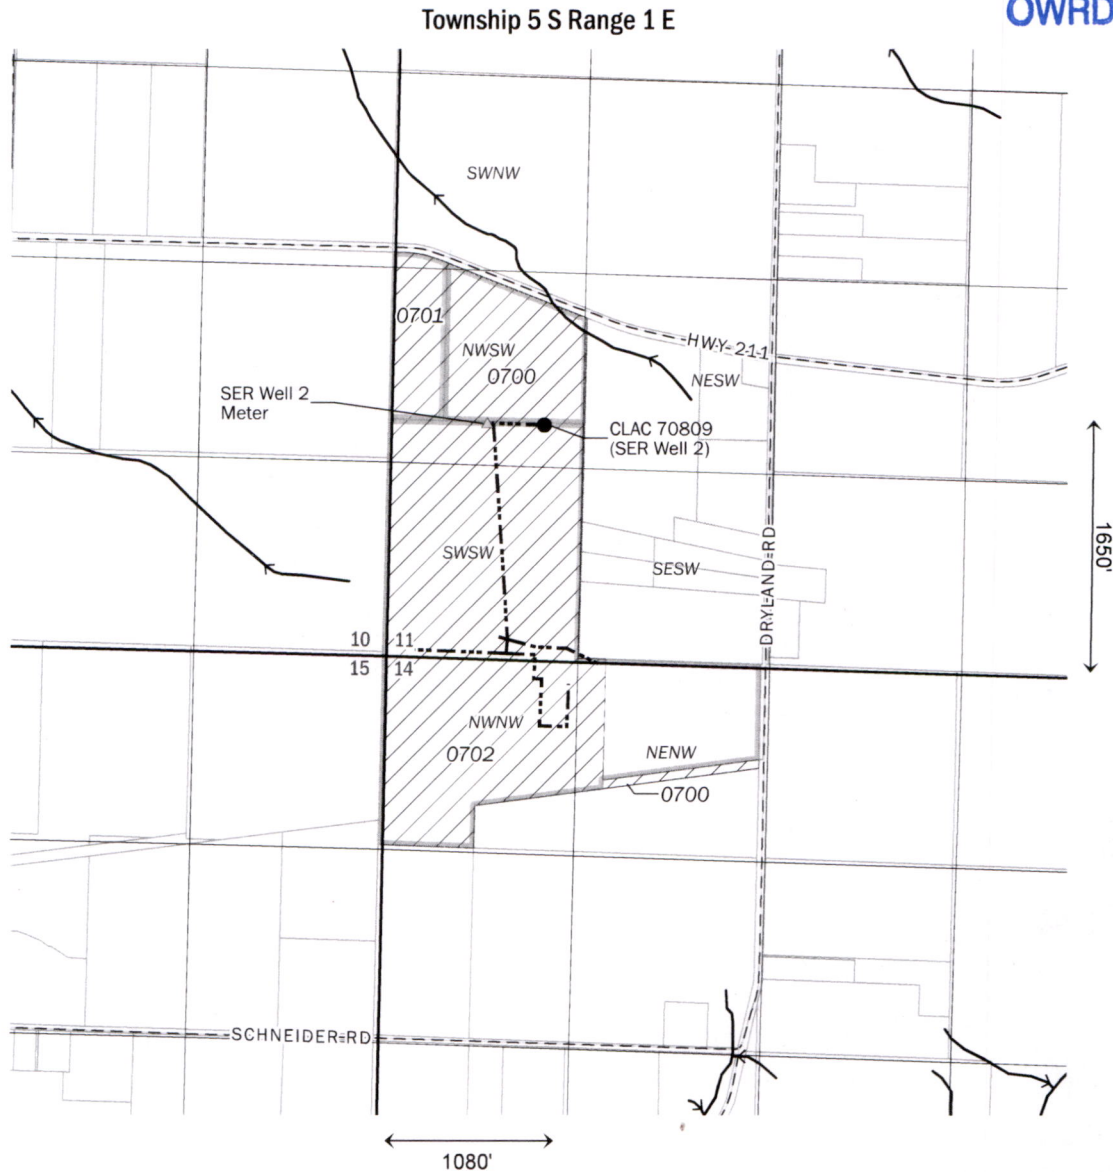

This map is not intended to provide legal dimensions
or locations of property ownership lines.

Received
FEB 07 2025
OWRD

- Point of Appropriation
- ▲ Flow Meter
- Place of Use
Agricultural and
Industrial/Manufacturing
- Source Pipe
- ← Stream
- Section
- Quarter Quarter
- Clackamas
County Tax
Parcel
- Willamette Egg
Farms Parcel



0 660 1,320
Feet
1 inch equals 1,320 feet

Permit G-17113

Claim of Beneficial Use
Willamette Egg Farms
Clackamas County, Oregon

Geosyntec
consultants

NOV-2024
PROJECT NO.
PNW0495

BY
KAM / KMJ
REVISED BY
--- / ---

FIGURE NO.
1