


Received
DEC 18 2024
OWRD

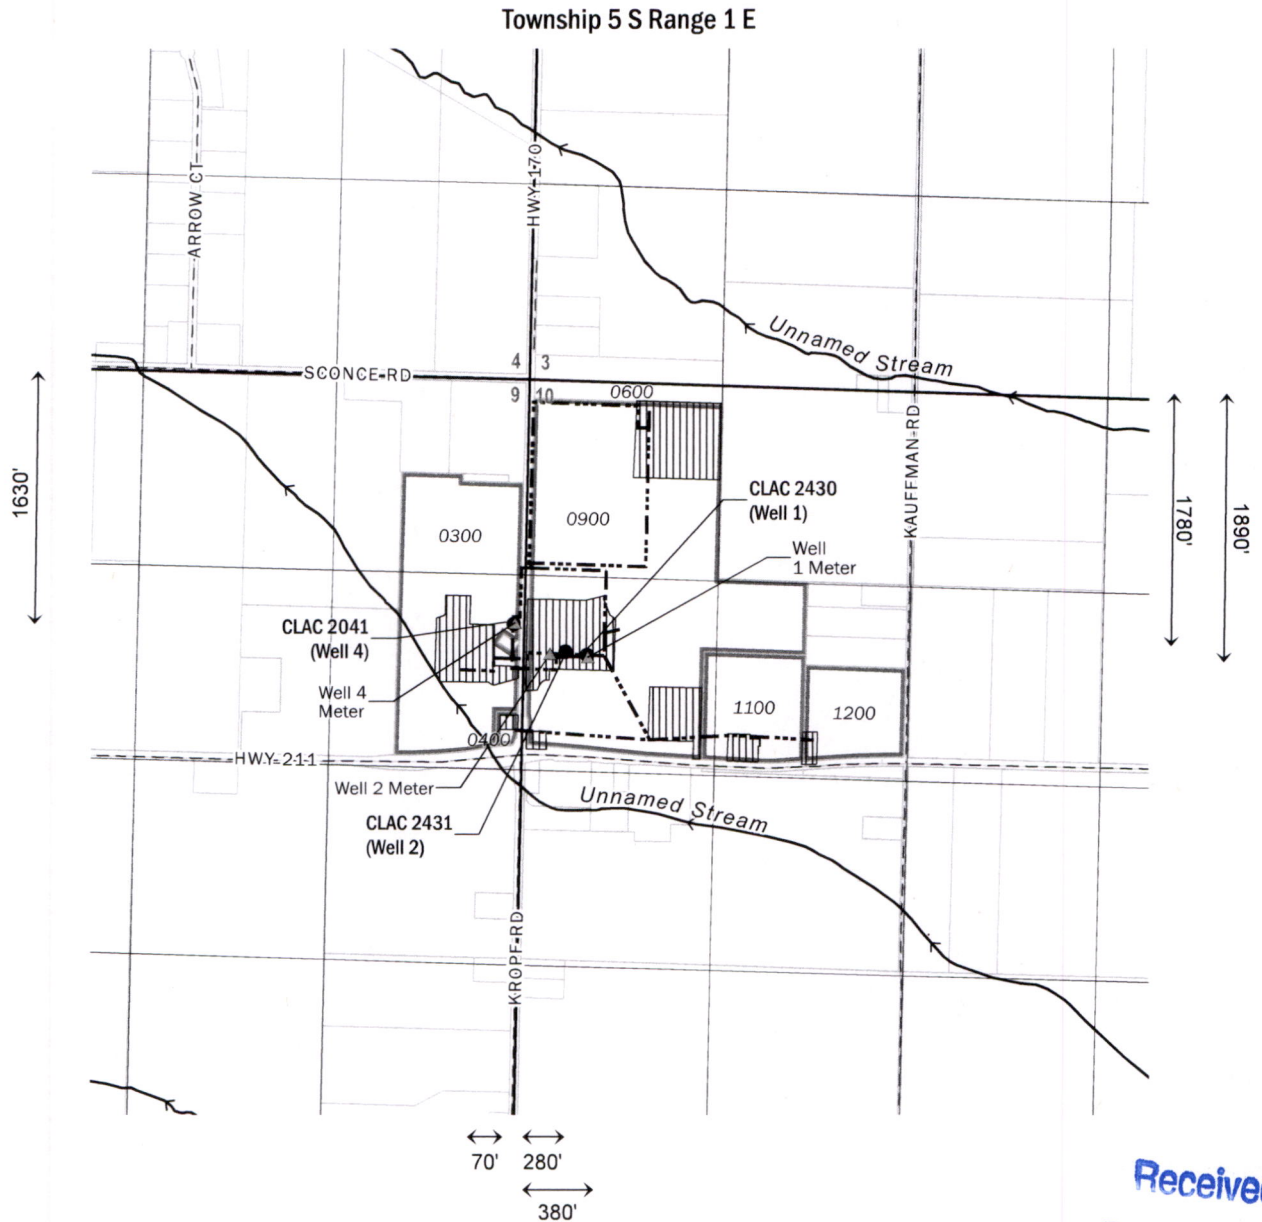

This map is not intended to provide legal dimensions
or locations of property ownership lines.

Received
FEB 07 2025
OWRD

- Point of Diversion
- ▲ Flow Meter
- ▨ Place of use Industrial
- Source Pipe
- ← Stream
- Section
- Quarter Quarter
- ▨ Clackamas County Tax Parcel
- ▨ Willamette Egg Farms Parcel



0 660 1,320
Feet
1 inch equals 1,320 feet

Permit G-18349

Claim of Beneficial Use
Willamette Egg Farms
Clackamas County, Oregon

Geosyntec
consultants

OCT-2024

PROJECT NO.
PNW0495

BY
KAM / KMJ

REVISED BY
--- / ---

FIGURE NO.

1