
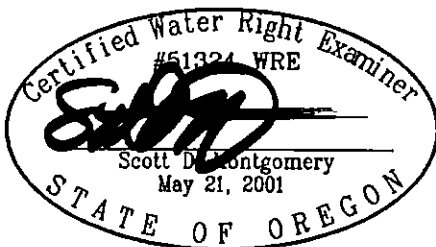



CLAIM OF BENEFICIAL USE MAP

TO ADD PLACE OF USE FOR STORAGE
PER APPLICATION R-35962
OREGON DEPARTMENT OF STATE LANDS

NW 1/4 SECTION 30, TOWNSHIP 27 SOUTH, RANGE 24 EAST, W.M.
TAX LOT: 1500, HARNEY COUNTY, OREGON

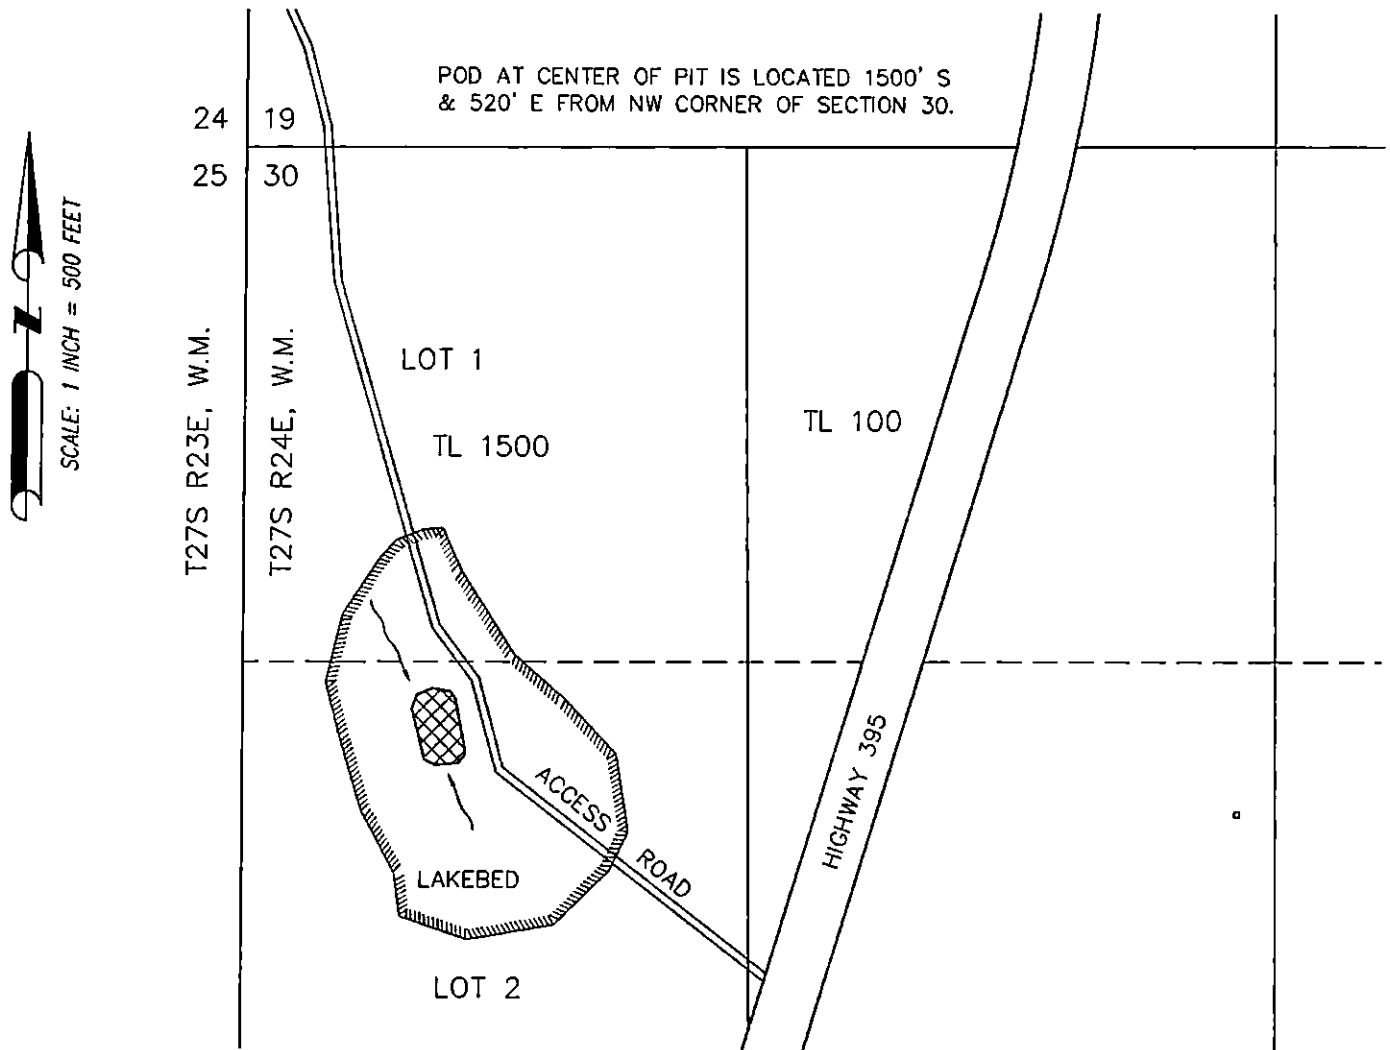

RENEWAL DATE: 12/31/2026

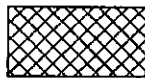

HIGHWAY LAKE

2.0 ACRE-FEET STO WITHIN SW
1/4 NW 1/4 SECTION 30 FROM
SEASONAL RUNOFF, AS SHOWN.

Renewed
OCT 27 2005
OCT 27 2005

THIS MAP IS FOR THE PURPOSE OF LOCATING A WATER RIGHT ONLY AND HAS NO
INTENT TO PROVIDE LEGAL DIMENSIONS OR THE LOCATION OF PROPERTY LINES.

PREPARED FOR:

OREGON DEPARTMENT OF STATE LANDS
775 SUMMER STREET NE #100
SALEM, OR 97301

PREPARED BY:



ALL POINTS ENGINEERING AND SURVEYING, INC.
P.O. BOX 767 TERREBONNE, OR 97760
(541) 548-5833
www.APEandS.com