

SEC. 20, T.14S., R.13E.,
W.M., DESCHUTES CO., OR.




WELL LOCATION

317' SOUTH AND 283'
WEST OF EAST 1/4 COR.
SEC. 20, T.14S., R.13E., W.M.,
DESCHUTES COUNTY, OR.

APPLICATION G-12803

PERMIT G-12377

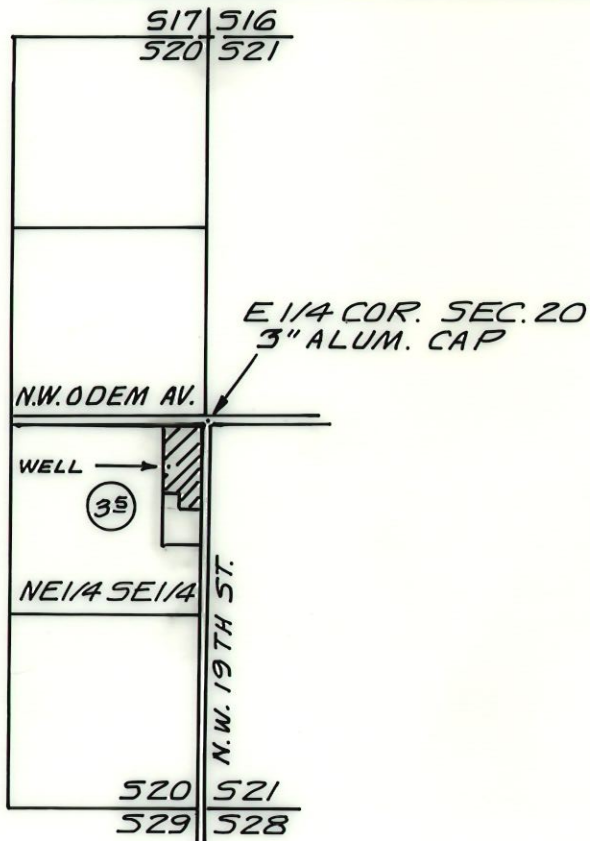

RECEIVED

JUL 21 1997

WATER RESOURCES DEPT.
SALEM, OREGON

PREPARED FOR

LARRY H. BROWN
NANCY BROWN
6997 N.W. 19TH STREET
TERREBONNE, OR 97760
C541J 923-0642

LEGEND



AREA IRRIGATED


35 ACRES

SURVEY NOTE

THE PREPARATION OF THIS MAP
IS FOR THE PURPOSE OF
IDENTIFYING THE LOCATION OF
THE WATER RIGHT ONLY AND
HAS NO INTENT TO PROVIDE
DIMENSIONS OR LOCATIONS OF
PROPERTY OWNERSHIP LINES.

FINAL PROOF
SURVEY MAP

ARMSTRONG SURVEYING
& ENGINEERING, INC.
378 EAST SECOND STREET
PRINEVILLE, OREGON 97754
C541J 447-7791

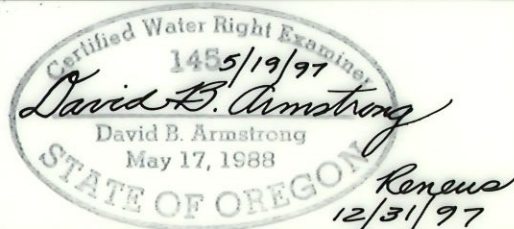

SCALE: 1"=1320'

DATE: MAY 19, 1997

W.O. 96-1441