


The Pond is located as follows: NE 1/4 SW 1/4, Section 30, T 35 S, R 5 W, W.M.
 1050 Feet South and 210 Feet West From
 The Center 1/4 Corner of Section 30

JOSEPHINE COUNTY

1" = 200'

This map was prepared for
 assessment purposes only.

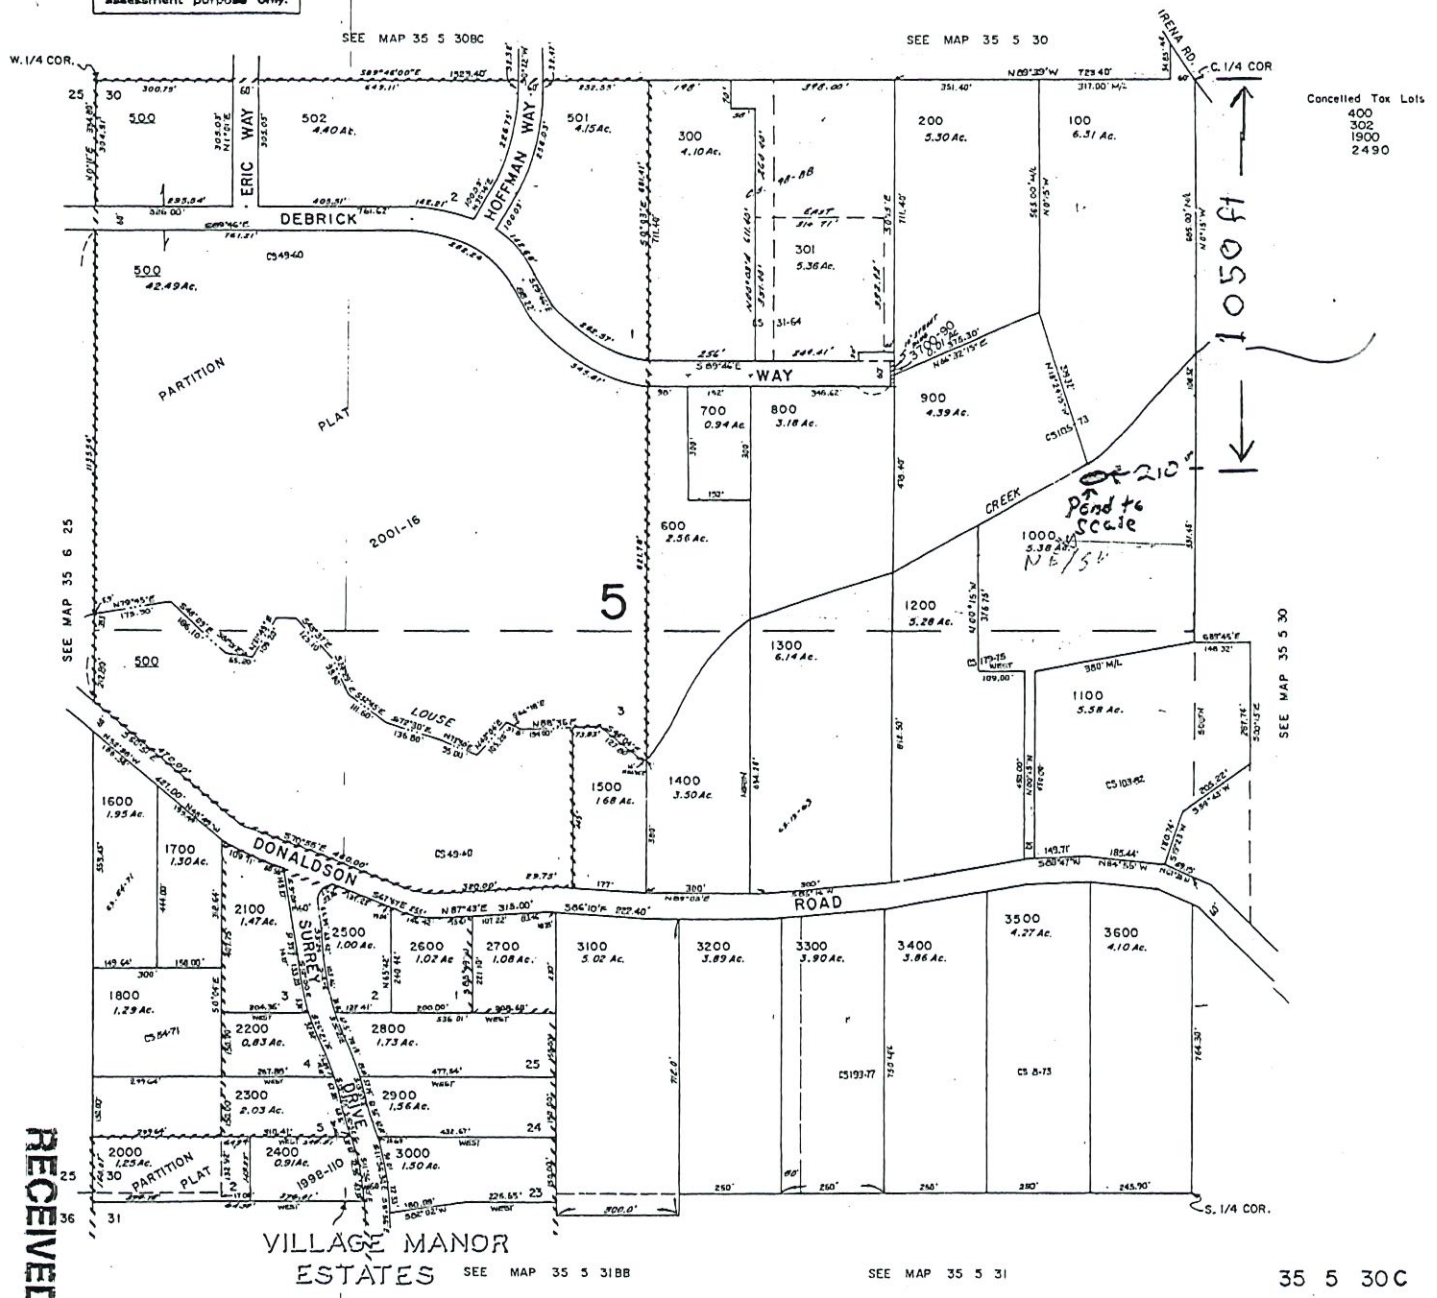

Cancelled Tax Lots
 400
 302
 1900
 2490

RECEIVED
 SEP 12 2018
 OWRD

RECEIVED

MAY 19 2006

WATER RESOURCES DEPT.
 RECEIVED
 SALEM, OREGON

SEP 23 2016

SALEM, OR

0 11292