


Township 7 South, Range 1 West, W.M.

Portions of Sections 8 & 9

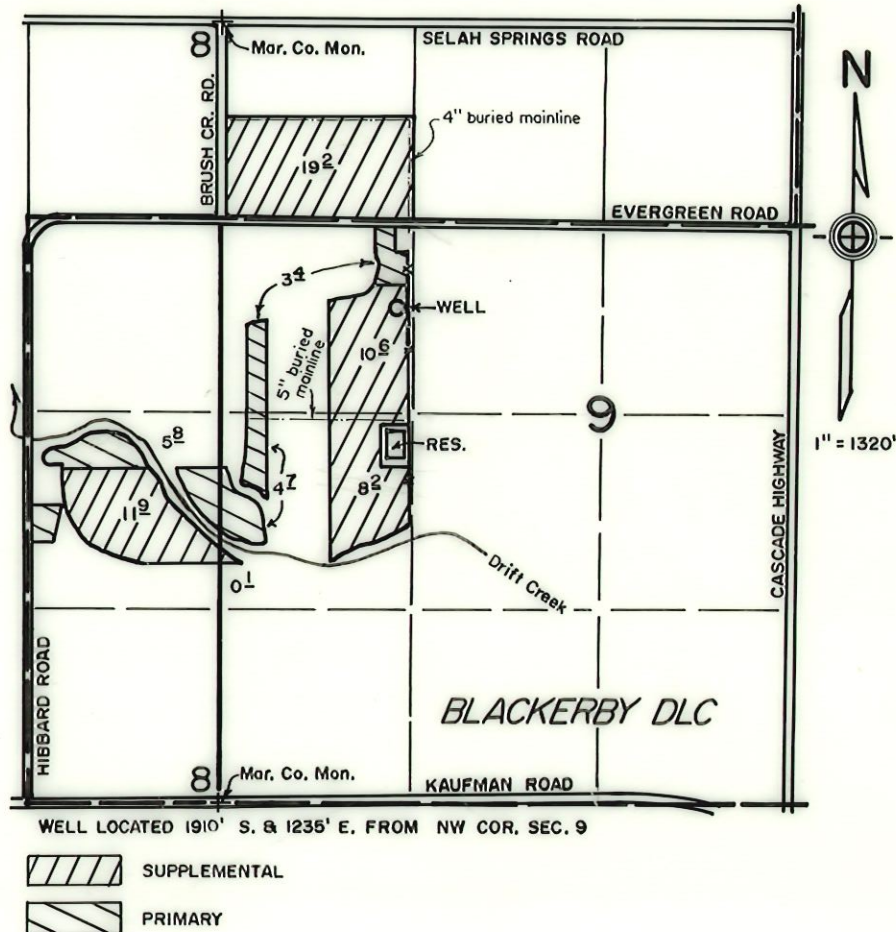


FINAL PROOF SURVEY
under
Appl. No. G-12878, Per. No. G-11737
in name of
ALFRED VON FLUE
Jan. 10, 1996

RECEIVED

JAN 22 1996

WATER RESOURCES DEPT
SALEM, OREGON

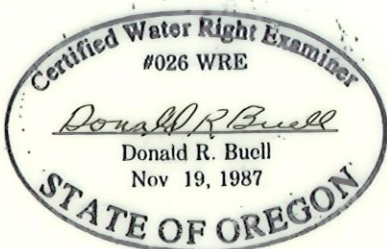

THIS MAP WAS PREPARED FOR THE PURPOSE OF IDENTIFYING THE LOCATION OF A WATER RIGHT ONLY AND IS NOT INTENDED TO PROVIDE LEGAL DIMENSIONS OR LOCATION OF PROPERTY OWNERSHIP LINES.