



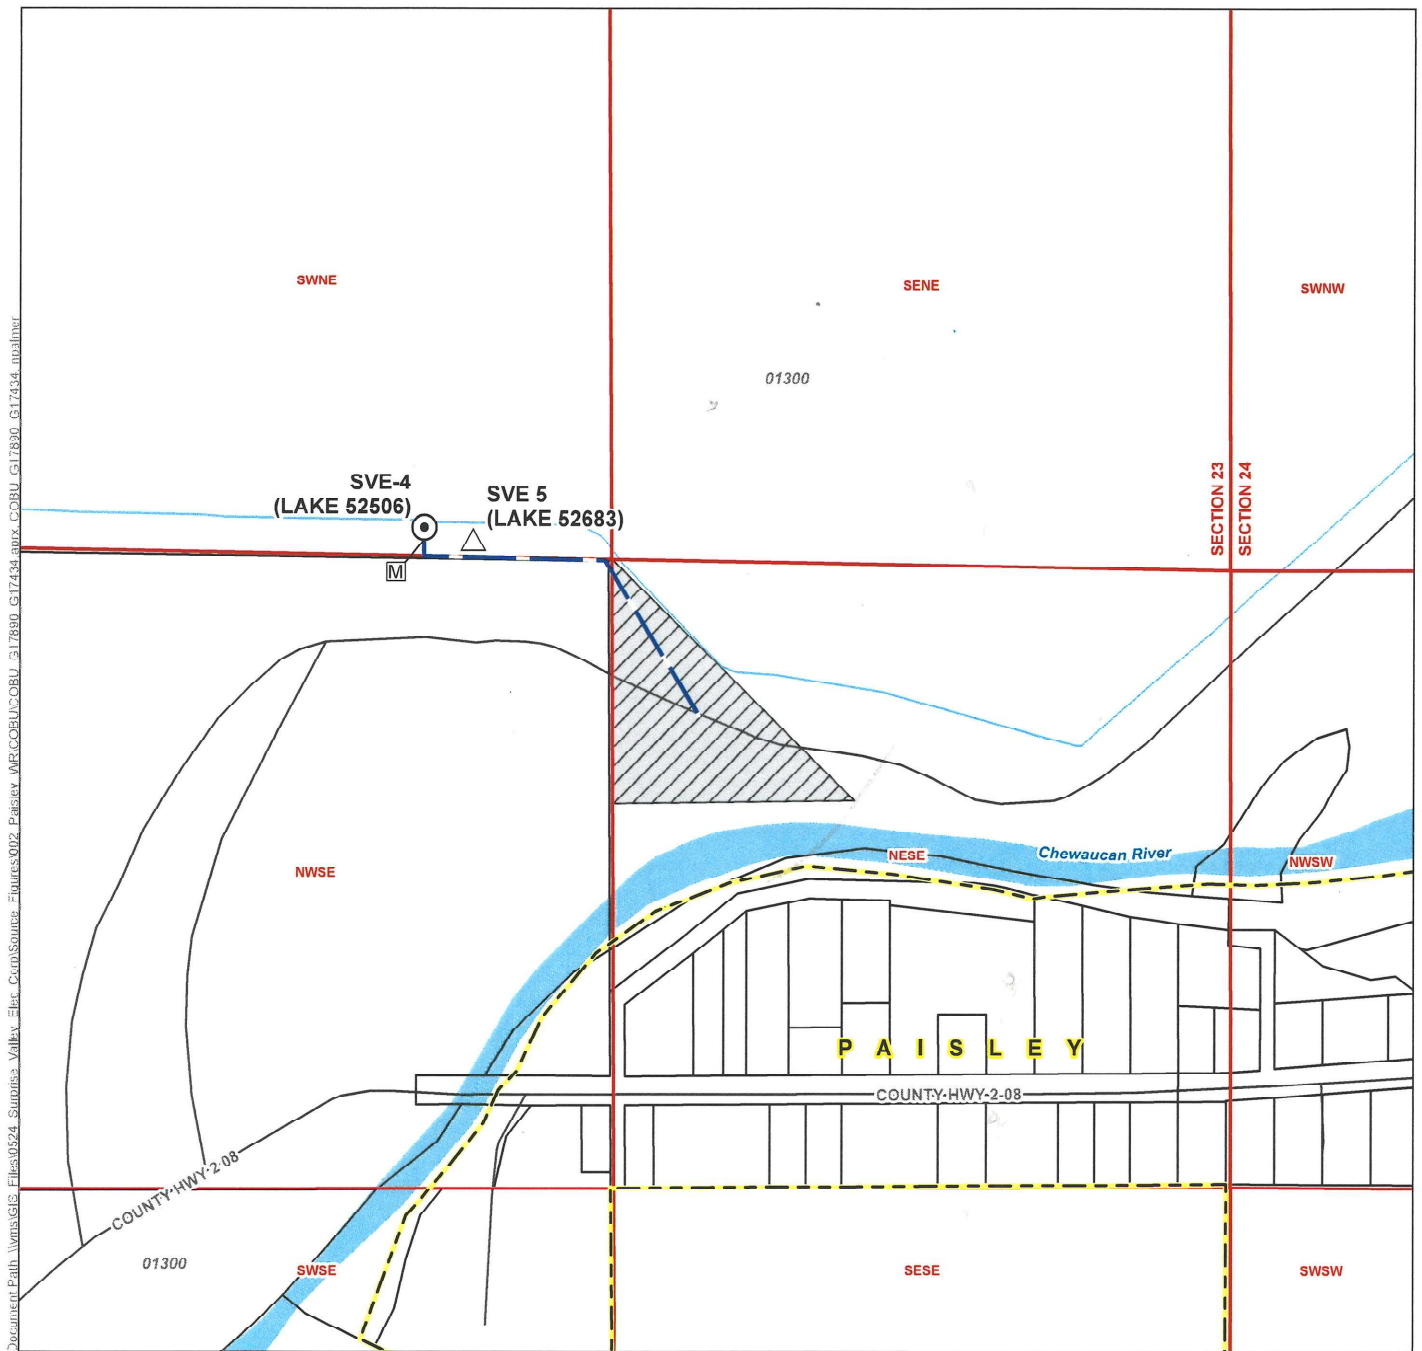

LEGEND

- | | |
|---|--------------------|
| ⊙ Authorized Point of Appropriation (POA) | All Other Features |
| △ Required Monitoring Well | City Boundary |
| M Meter | Tax Lot |
| — Distribution Pipeline | Road |
| ▨ Place of Use (POU) | Watercourse |

CERTIFIED WATER RIGHTS EXAMINER STAMP

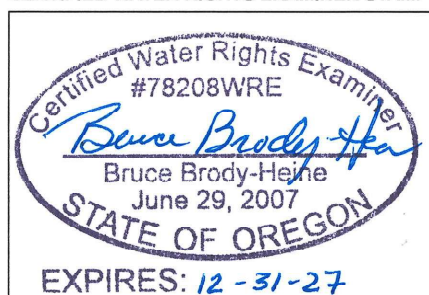

LOCATION DESCRIPTION

SVE-4
 Located 60 feet North and 1,680 feet West from the E 1/4 corner of Section 23, Township 33 South, Range 18 East (W.M.)
 X: 42.696615, Y: -120.559674 (WGS84)

SVE-4 Meter Location
 Meter is located 10 feet to South of wellhead.

SVE-5
 Located 70 feet North and 1,580 feet West from the E 1/4 corner of Section 23, Township 33 South, Range 18 East (W.M.)
 X: 42.696542, Y: -120.55928 (WGS84)

Claim of Beneficial Use Surprise Valley Electrification Corporation Place of Use/Point of Appropriation Map

Application G-17890; Permit G-17434

Township 33 South, Range 18 East (W.M.)

DISCLAIMER

This map was prepared for the purpose of identifying the location of a water right only and it is not intended to provide legal dimensions or location of property ownership lines.

Date: June 15, 2026
 Data Sources: BLM, ESRI, OWRD, USGS

