

T 24 S. R. 30 E. W. M.


T 24 S R 30 E

G 2363  
G 3358  
G 3419  
G 3420  
G 4233

RECEIVED

Application No. G-9521  
Permit No. G 8912

7 JAN 22 1980  
WATER RESOURCES DEPT  
SALEM, OREGON

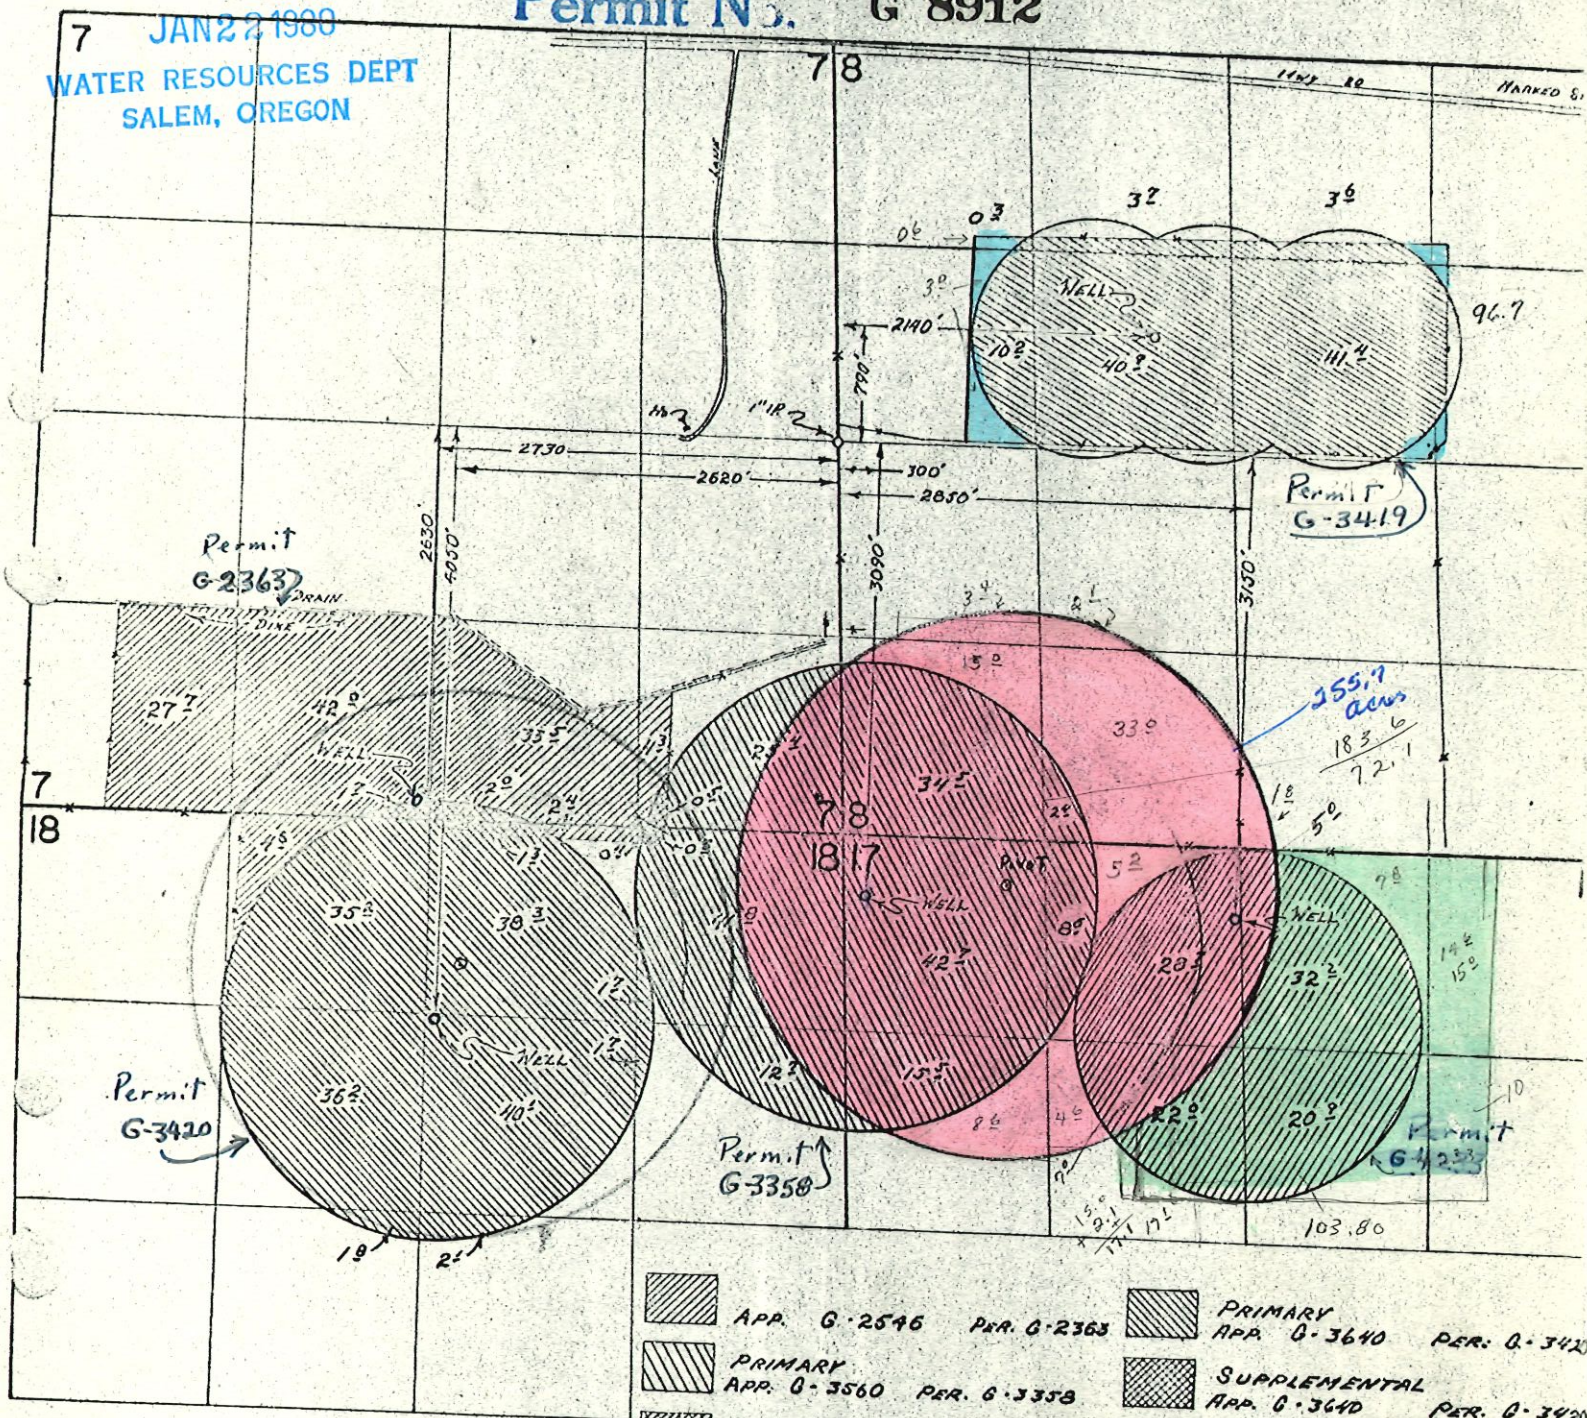

|                                                                                     |              |             |                                                                                       |                                                                                       |              |             |             |
|-------------------------------------------------------------------------------------|--------------|-------------|---------------------------------------------------------------------------------------|---------------------------------------------------------------------------------------|--------------|-------------|-------------|
|  | APR. G-2546  | PAR. G-2363 |  | PRIMARY                                                                               | APR. G-3640  | PER. G-3420 |             |
|  | PRIMARY      | APR. G-3560 | PER. G-3358                                                                           |  | SUPPLEMENTAL | APR. G-3640 | PER. G-3420 |
|  | SUPPLEMENTAL | APR. G-3560 | PER. G-3358                                                                           |  | APR. G-4491  | PAR. G-4233 |             |
|  | APR. G-3639  | PER. G-3419 |                                                                                       |                                                                                       |              |             |             |

Key Title & Escrow

3975 River Rd North

Salem, Or 97310

J.J. Pragasitis  
Ken Smith

FINAL PROOF SURVEY

Donna Merzi mng.

Escrow # 5-10850

8-17

Application No. G-2546  
Permit No. G-2363  
G-3358  
G-3419  
G-3420  
G-4233

ADOLF J. KISLE