


T.7S. R.2W. Sec. 28, 29, 32, & 33, W.M.

Woodside
DLC 74

Caplinger
DLC 75

Rickey
DLC 81

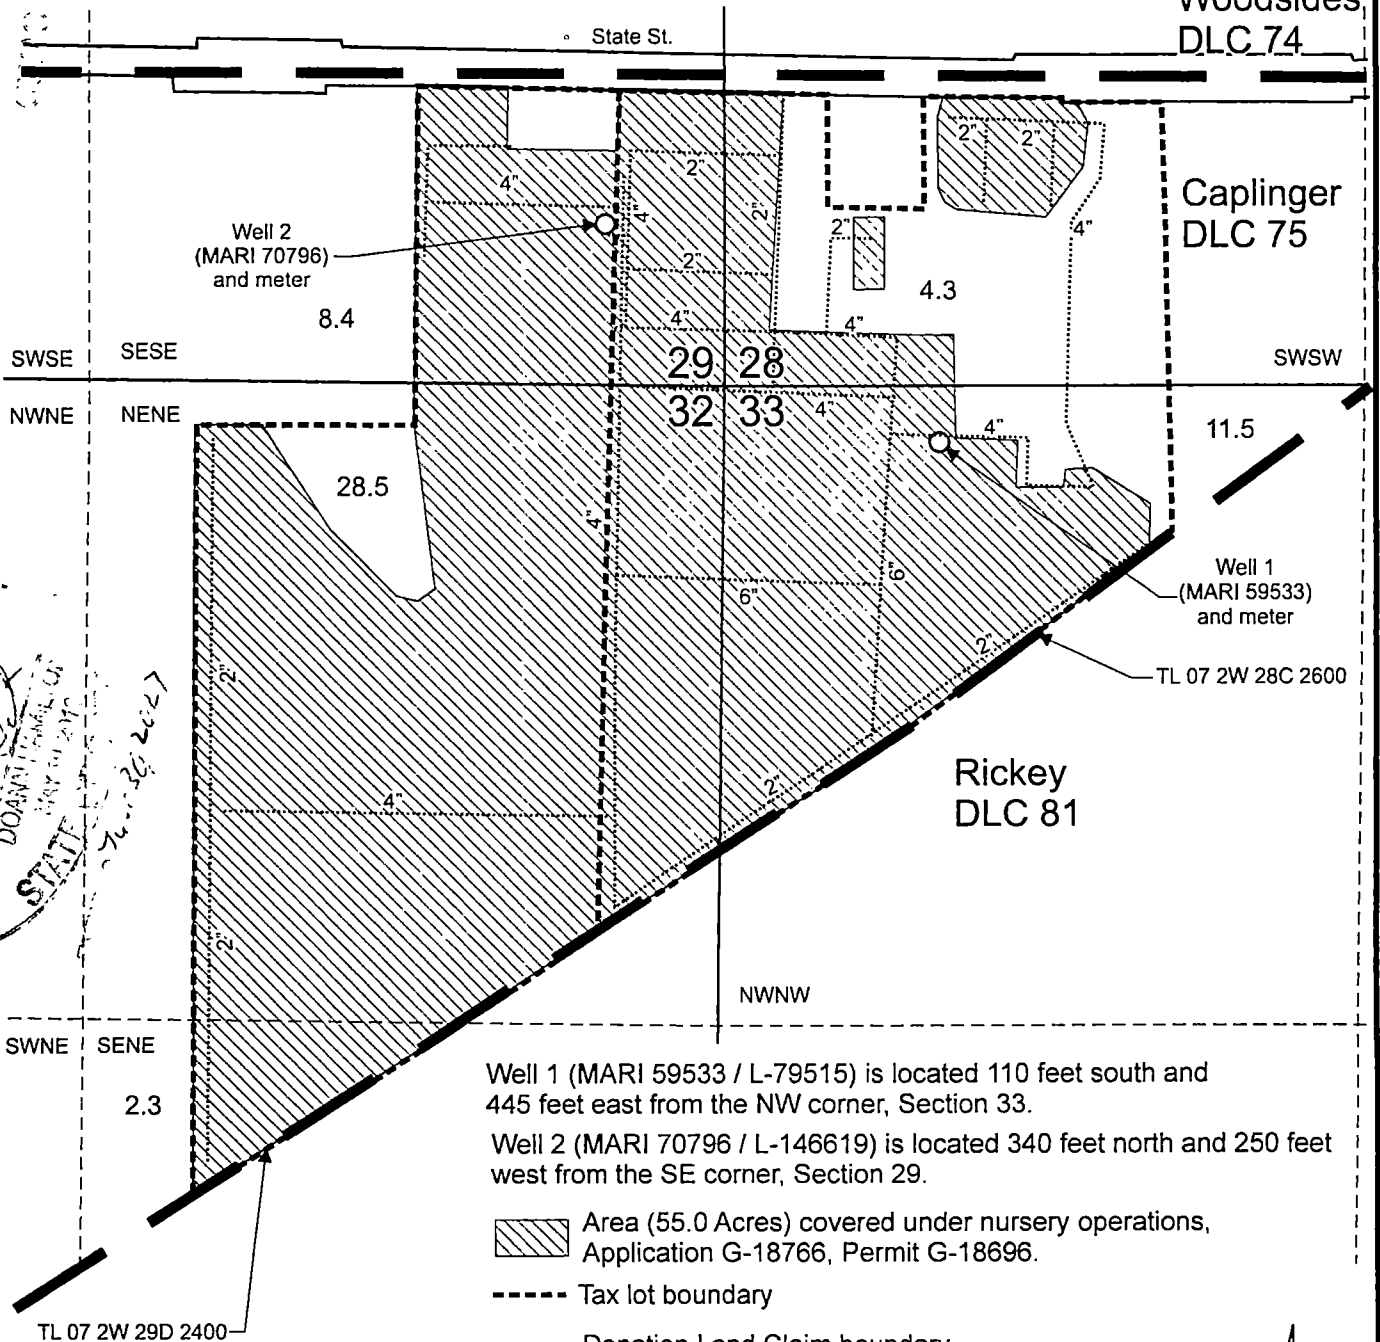

Well 1 (MARI 59533 / L-79515) is located 110 feet south and 445 feet east from the NW corner, Section 33.

Well 2 (MARI 70796 / L-146619) is located 340 feet north and 250 feet west from the SE corner, Section 29.


 Area (55.0 Acres) covered under nursery operations, Application G-18766, Permit G-18696.

 Tax lot boundary

 Donation Land Claim boundary

 Water main line

Scale: 1" = 400'

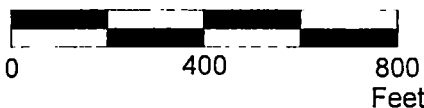

This map was prepared for the purpose of identifying the location of a water right only and is not intended to provide legal dimensions or location of property ownership lines.

Claim of Beneficial Use Map
Application G-18766, Permit G-18696

JLPN Inc.
T.7S. R.2W. Sec. 28, 29, 32, & 33, W.M.

03/2026

 WILL MCGILL SURVEYING LLC

JLPNG-18766COBUMap.cdr