


EXHIBIT B

T29S, R30E, W.M.
Harney County, Oregon

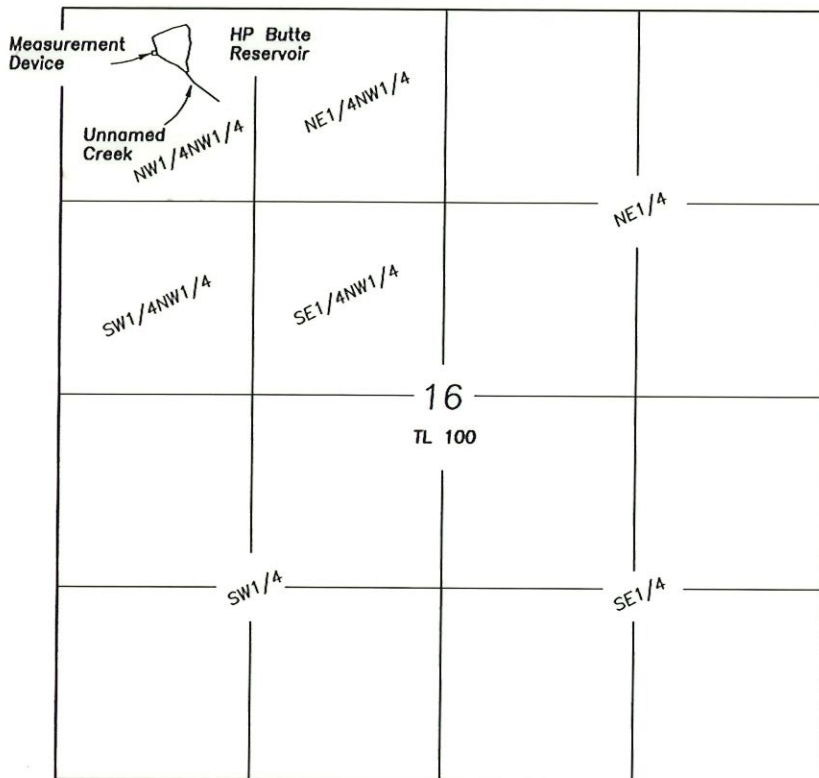

SCALE 1"=1320'

Outlet is located 260' South & 640' East of the
NW corner of Section 16.

Measuring device is located 14' South and 12' East of the Outlet.

FINAL PROOF SURVEY
CLAIM OF BENEFICIAL USE
HP BUTTE RESERVOIR

For

Bureau of Land Management

June 7, 2017

LEGEND

Application No. R-59653
Permit No. R-8085
Priority 12/21/1979

A portion of Tax Lot
29-30 TL100

NOTE: Tax Lot 100 is owned by the BLM
and is more that 22,000 acres.
No boundaries of the tax lot
can be shown.

Prepared by
Cornerstone Surveying, Inc

P.O. BOX 33
JOHN DAY, OR. 97845

(541)575-1813

cornerstonesurvey@centurytel.net

NOTE: The preparation of this map
was for the purpose of identifying
the location of the proposed water
right and has no intent to provide
dimensions or location of property
ownership lines.

RECEIVED BY OWRD

NOV 03 2017

SALEM, OR

