

T.4S. R.1W. Sec. 7 & 18, W.M.


Received by CWRD

JAN 09 2025

Salem, OR

- Donation Land Claim boundary
- - - Tax lot boundary
- Irrigation mainlines

DOANN HAMILTON
MAY 10, 2012
STATE OF OREGON
DO-2022-34-30-2027

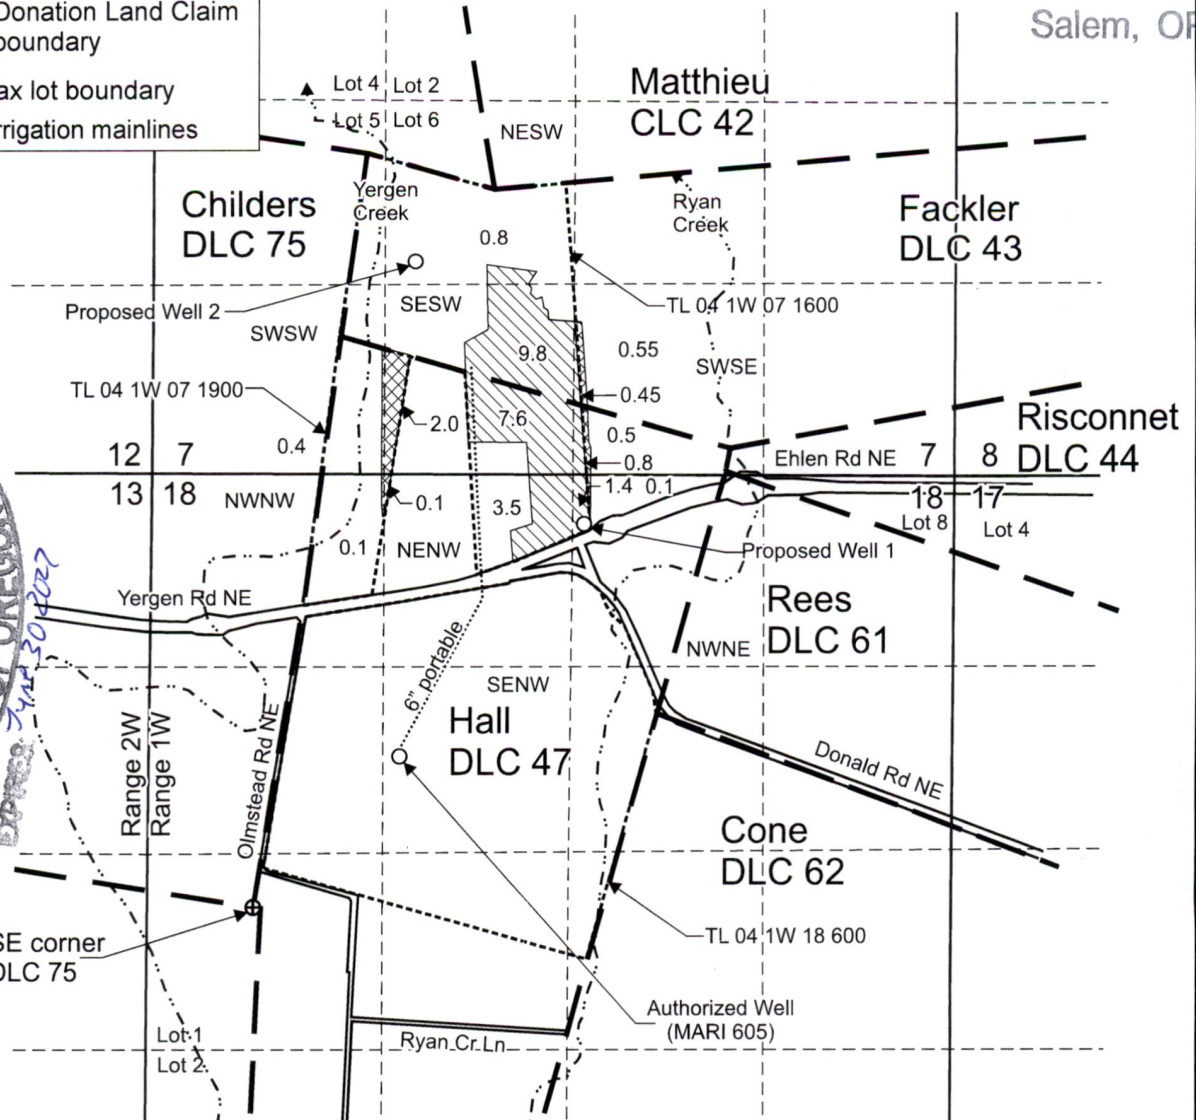

Authorized Well (MARI 605) is located 1,040 feet north and 1,020 feet east from the SE corner, DLC 75.

Proposed Well 1 is located 280 feet south and 2,575 feet west from the NE corner, Section 18.

Proposed Well 2 is located 1,460 feet north and 1,830 feet east from the SW corner, Section 7.

 Area (24.35 Acres) irrigated under Certificate 93404, priority date 4-14-1978 affected by this transfer.

 Area (3.75 Acres) irrigated under Certificate 93404, priority date 4-14-1978 not affected by this transfer.

Scale: 1" = 1,320'



This map was prepared for the purpose of identifying the location of a water right only and is not intended to provide legal dimensions or location of property ownership lines.

Transfer Application Map Certificate 93404

Molalla Poultry Inc. c/o Tuan Tiet
T.4S. R.1W. Sec. 7 & 18, W.M.

12/2025

 WILL MCGILL SURVEYING LLC

14804 -


Application No. G-11419
Permit No.

RECEIVED

JAN 29 1986

WATER RESOURCES DEPT
SALEM, OREGON

T. 4S., R. 1W., W.M.

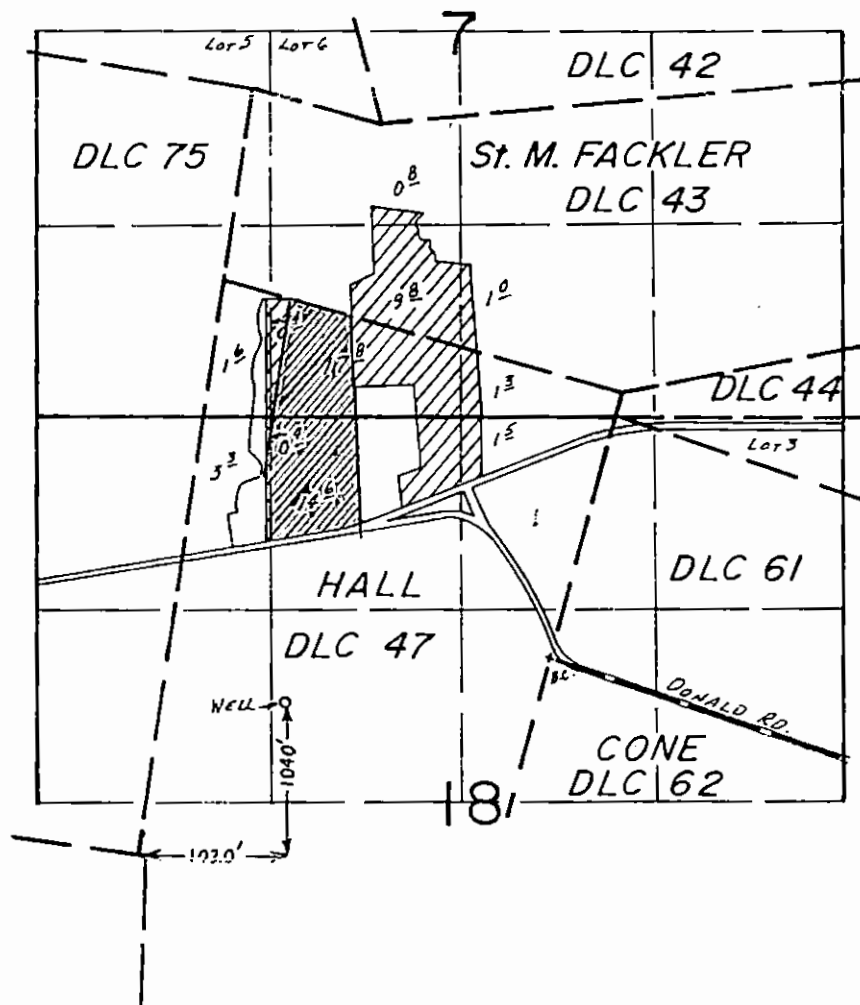

FINAL PROOF SURVEY
UNDER

Application No. G-7860. Permit No. G-8165.....
IN NAME OF

.....FRANCIS X. RYAN.....

Surveyed OCT. 4.... 1983., by L.M. TOLL.....