



TRANSFER MAP FOR A PORTION OF CERT 55015  
IN THE NAME OF GLENN ROHDE  
T3N, R30E, W.M. UMATILLA COUNTY

Received  
OCT 07 2024

OWRD

"FROM MAP"

"TO MAP"

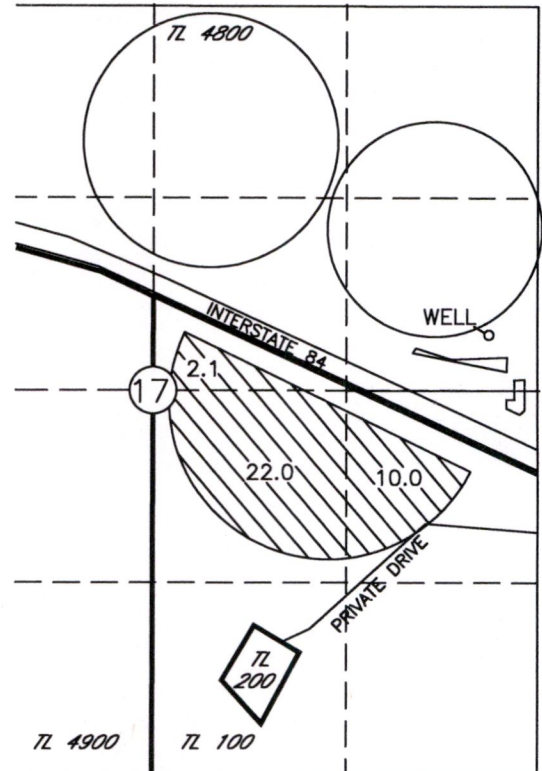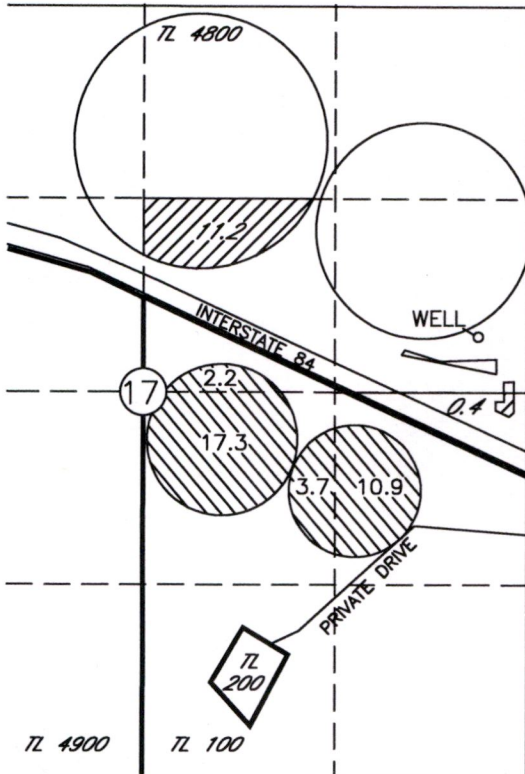

LEGEND

CERT 55015 ACREAGE TO BE TRANSFERRED 34.1 AC


CERT 55015 ACREAGE IN QTR QTR NOT INVOLVED IN THIS TRANSFER

AUTHORIZED POINT OF APPROPRIATION  
WELL - LOCATED 2300' SOUTH AND  
250' WEST FROM THE NE CORNER  
OF SECTION 17

LEGEND

34.1 AC FROM ORIGINATING  
CERT 55015

AUTHORIZED POINT OF APPROPRIATION  
WELL - LOCATED 2300' SOUTH AND  
250' WEST FROM THE NE CORNER  
OF SECTION 17

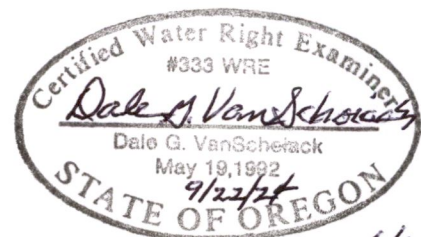

Renews 6/30/26

Sept 22 2024

NOTE:  
THE PURPOSE OF THIS MAP IS TO IDENTIFY THE APPROXIMATE LOCATION  
OF THE WATER RIGHT. IT IS NOT INTENDED TO PROVIDE INFORMATION  
RELATIVE TO THE LOCATION OF PROPERTY OWNERSHIP BOUNDARY LINES.

