

CLAIM OF BENEFICIAL USE MAP

TO ADD PLACE OF USE AND
POINTS OF APPROPRIATION
PER APPLICATIONS G-16207
FOR JUSTIN & STEPHANIE BOWEN & ED SNIPES

DEC 10 2025

Salem, OR

● #1 (HARN 1913)

LOCATED IN THE SE 1/4 SE 1/4, SECTION 36, T25S, R33E, W.M. AND 67 FEET NORTH 1833 FEET WEST FROM THE NE CORNER OF SECTION 1, T26S, R33E.

FLOW METER IS LOCATED ON PIPE 73 FEET SW OF WELL & 2 FEET NE OF CENTER PIVOT.

● #2 (HARN 1867)

LOCATED IN THE SW 1/4 SE 1/4, SECTION 36, T25S, R33E, W.M. AND 1165 FEET NORTH 3570 FEET WEST FROM THE NE CORNER OF SECTION 1, T26S, R33E, W.M.

FLOW METER IS LOCATED ON PIPE 25 FEET EAST OF THE WELL & 4 FEET WEST OF CENTER PIVOT.

● #3 (HARN 2072)

LOCATED IN THE NW 1/4 SW 1/4 (LOT 3), SECTION 31, T25S, R34E, W.M. AND 2155 FEET NORTH 1580 FEET WEST FROM THE NE CORNER OF SECTION 1, T26S, R33E, W.M.

FLOW METER IS LOCATED ON PIPE 4 FEET NORTH OF WELL

● #4 (HARN 51154)

LOCATED IN THE SW 1/4 NE 1/4, SECTION 36, T25S, R33E, W.M. AND 2160 FEET SOUTH 2125 FEET WEST FROM THE NE CORNER OF SAID SECTION.

FLOW METER IS LOCATED ON PIPE 78 FEET SE OF THE WELL & 4 FEET SOUTH OF CENTER PIVOT.

● #5 (HARN 50236)

LOCATED IN THE NW 1/4 NE 1/4, SECTION 36, T25S, R33E, W.M. AND 760 FEET SOUTH 1845 FEET WEST FROM THE NE CORNER OF SAID SECTION.

FLOW METER IS LOCATED ON PIPE 7 FEET SW OF WELL & 4 FEET NE OF CENTER PIVOT.

● #6 (HARN 51075)

LOCATED IN THE NE 1/4 NE 1/4, SECTION 36, T25S, R33E, W.M. AND 1030 FEET SOUTH 30 FEET WEST FROM THE NE CORNER OF SAID SECTION.

FLOW METER IS LOCATED ON PIPE 12 FEET SE OF THE WELL & 4 FEET NW OF CENTER PIVOT.

● #7 (HARN 51837)

LOCATED IN THE NE 1/4 SW 1/4, SECTION 36, T25S, R33E, W.M. AND 1350 FEET NORTH 5780 FEET WEST FROM THE NE CORNER OF SECTION 1, T26S, R33E, W.M.


FLOW METER IS LOCATED ON PIPE 12 FEET SW OF WELL & 4 FEET NE OF CENTER PIVOT.

TOWNSHIP 25 SOUTH, RANGE 33 EAST, SECTION 36, W.M.
TAX LOT: 900 & 9700
TOWNSHIP 25 SOUTH, RANGE 34 EAST, SECTION 31, W.M.
TAX LOTS: 2500 & 2501
TOWNSHIP 26 SOUTH, RANGE 33 EAST, SECTION 1, W.M.
TAX LOTS: 102 & 500
HARNEY COUNTY, OREGON


● #8 (HARN 51443)

LOCATED IN THE NW 1/4 NW 1/4, SECTION 31, T25S, R34E, W.M. AND 50 FEET SOUTH 930 FEET EAST FROM THE NW CORNER OF SECTION 31.

FLOW METER IS LOCATED ON PIPE 6 FEET E OF THE WELL.

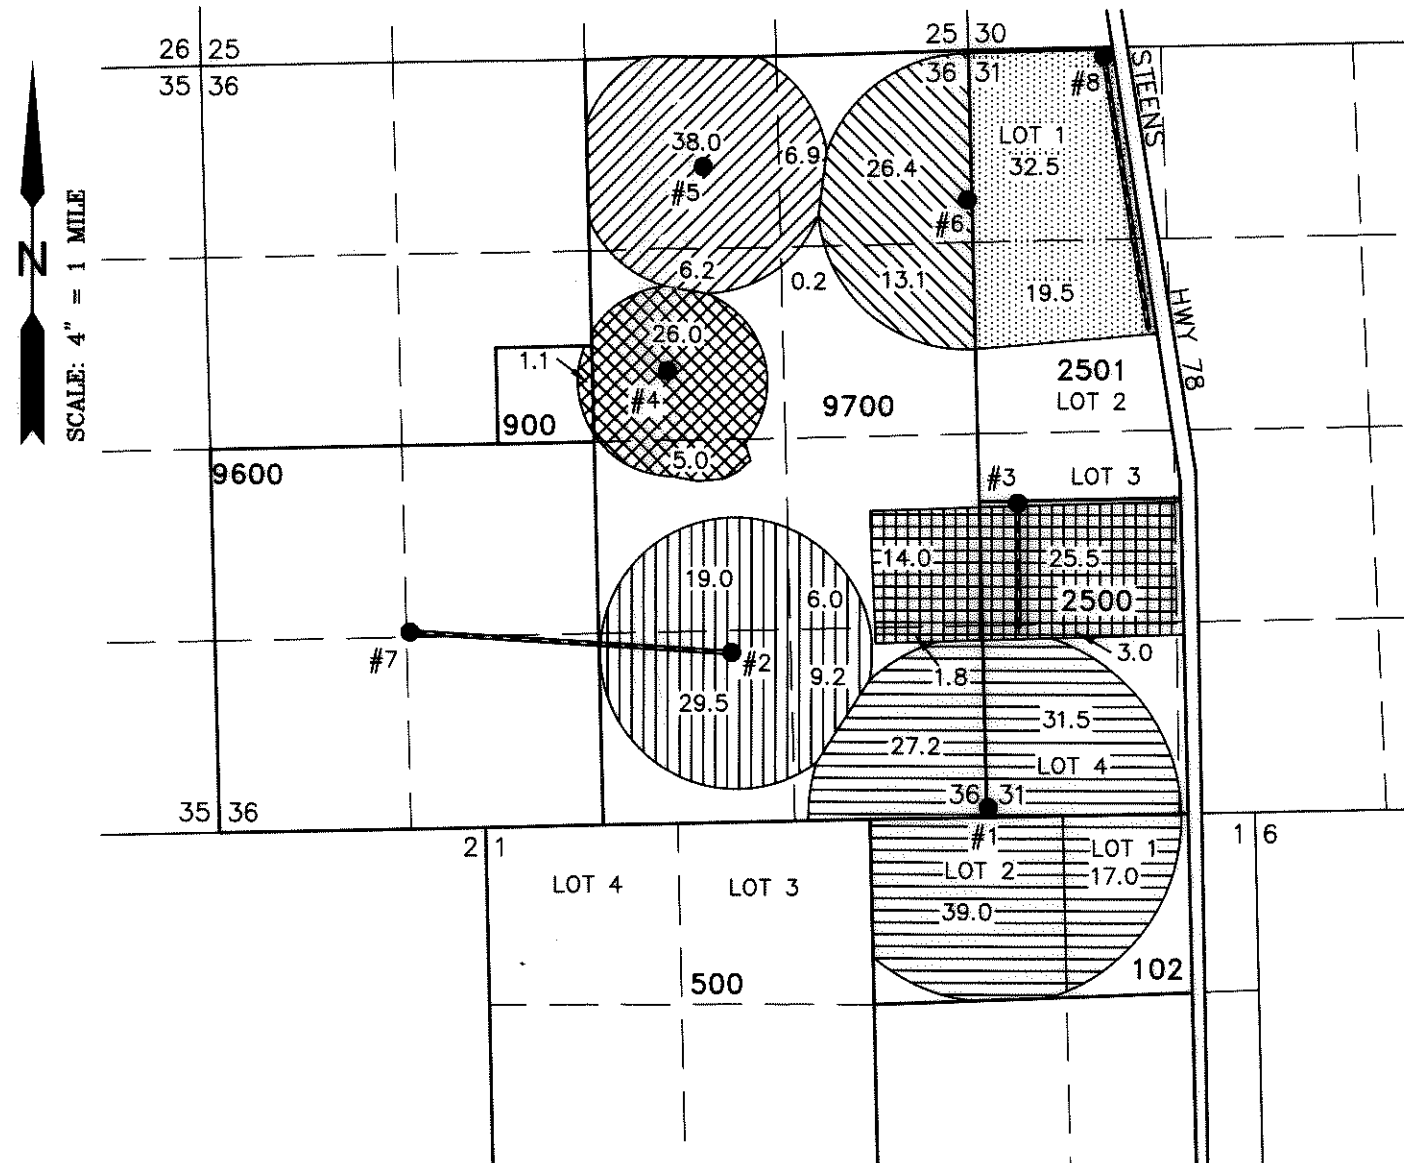

- 52.0 ACRES IR FROM WELL 8 BY PERMIT G-18499, AS SHOWN
- 39.5 ACRES IR FROM WELL 6 BY PERMIT G-18499, AS SHOWN
- 51.3 ACRES IR FROM WELL 5 BY PERMIT G-18499, AS SHOWN
- 32.1 ACRES IR FROM WELL 4 BY PERMIT G-18499, AS SHOWN
- 44.3 ACRES IR FROM WELL 3 BY PERMIT G-18499, AS SHOWN
- 63.7 ACRES IR FROM WELLS 2 & 7 BY PERMIT G-18499, AS SHOWN
- 114.7 ACRES IR FROM WELL 1 BY PERMIT G-18499, AS SHOWN

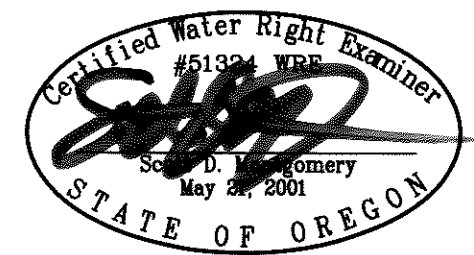

RENEWAL DATE: 12/31/2026

THIS MAP IS FOR THE PURPOSE OF LOCATING A WATER RIGHT ONLY AND HAS NO INTENT TO PROVIDE LEGAL DIMENSIONS OR THE LOCATION OF PROPERTY LINES

PREPARED FOR:

JUSTIN & STEPHANIE BOWEN
55288 HWY 78
BURNS, OR 97720

PREPARED BY:



ALL POINTS ENGINEERING AND SURVEYING, INC.
P.O. BOX 767
(541) 548-5833
TERREBONNE, OR 97760
www.APEandS.com