


T.3S. R.4W. Sec. 13 & 24, W.M.

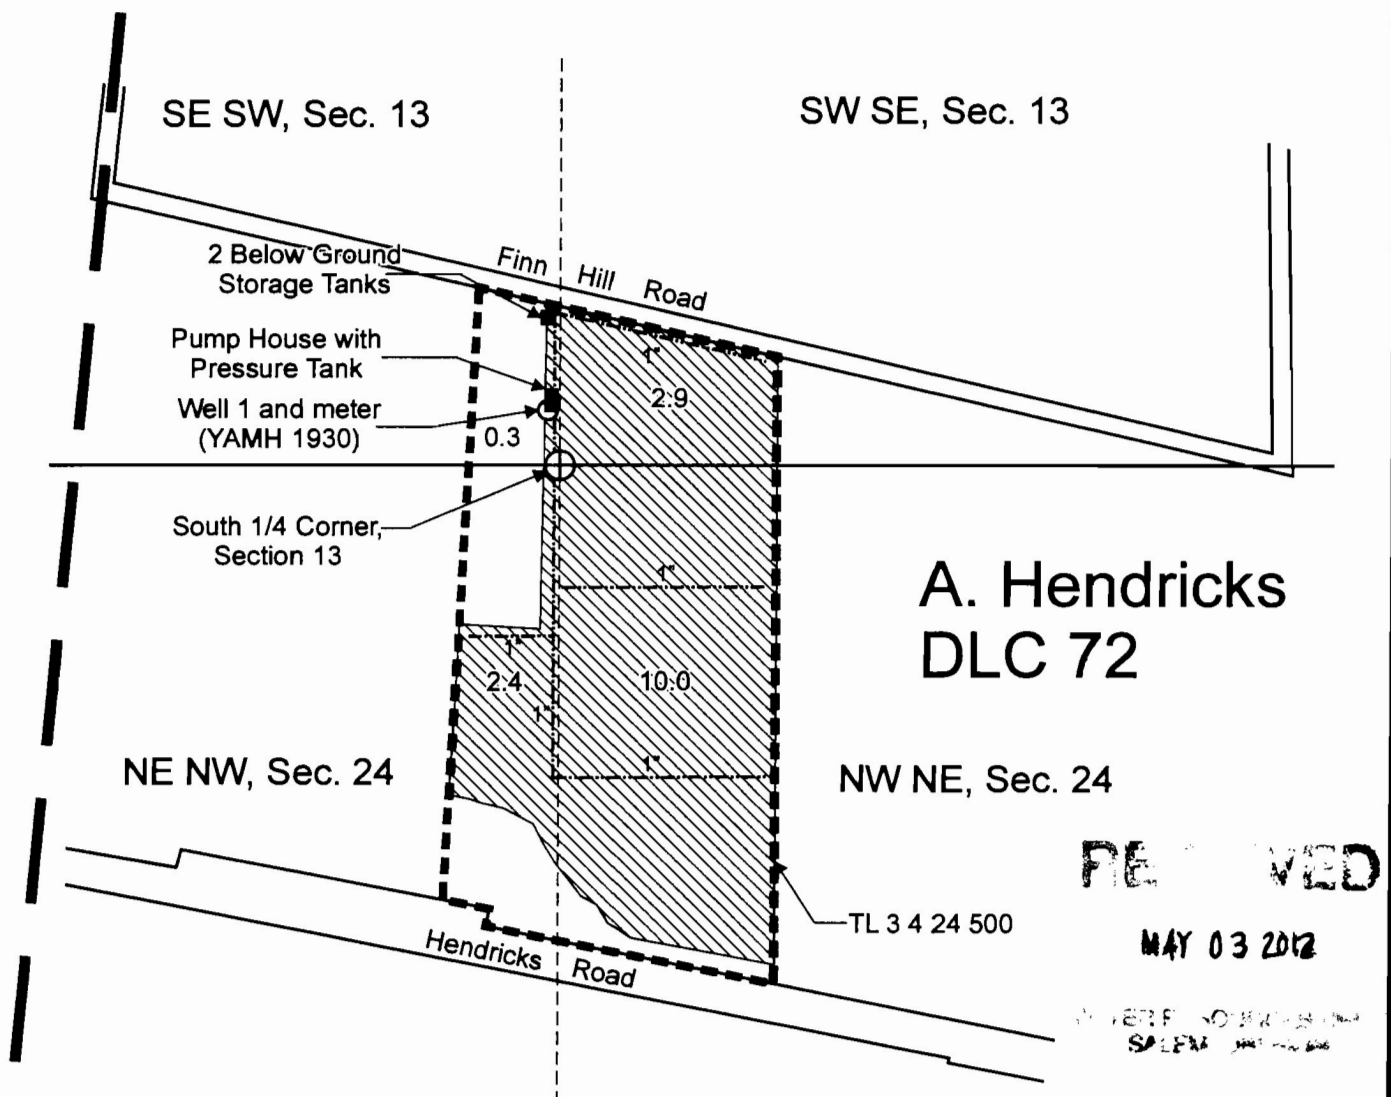

Well 1 (YAMH 1930) is located 120 feet north and 30 feet west from the S 1/4 corner, Section 13.


Area (15.6 Acres) irrigated under Application G-17402, Permit G-16813.

Tax lot boundary

Donation Land Claim Boundary

Irrigation main line buried

Scale: 1" = 400'

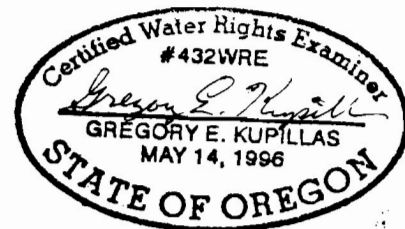

EXPIRATION DATE: 6/30/2013

This map was prepared for the purpose of identifying the location of a water right only and is not intended to provide legal dimensions or location of property ownership lines.

Claim of Beneficial Use Map
Application G-17402, Permit G-16813

Earl Lumpkins
T.3S. R.4W. Sec. 13 & 24, W.M.

Pacific Hydro-Geology Inc.

04/2012