T.3N. R.2W. Section 36, W.M.

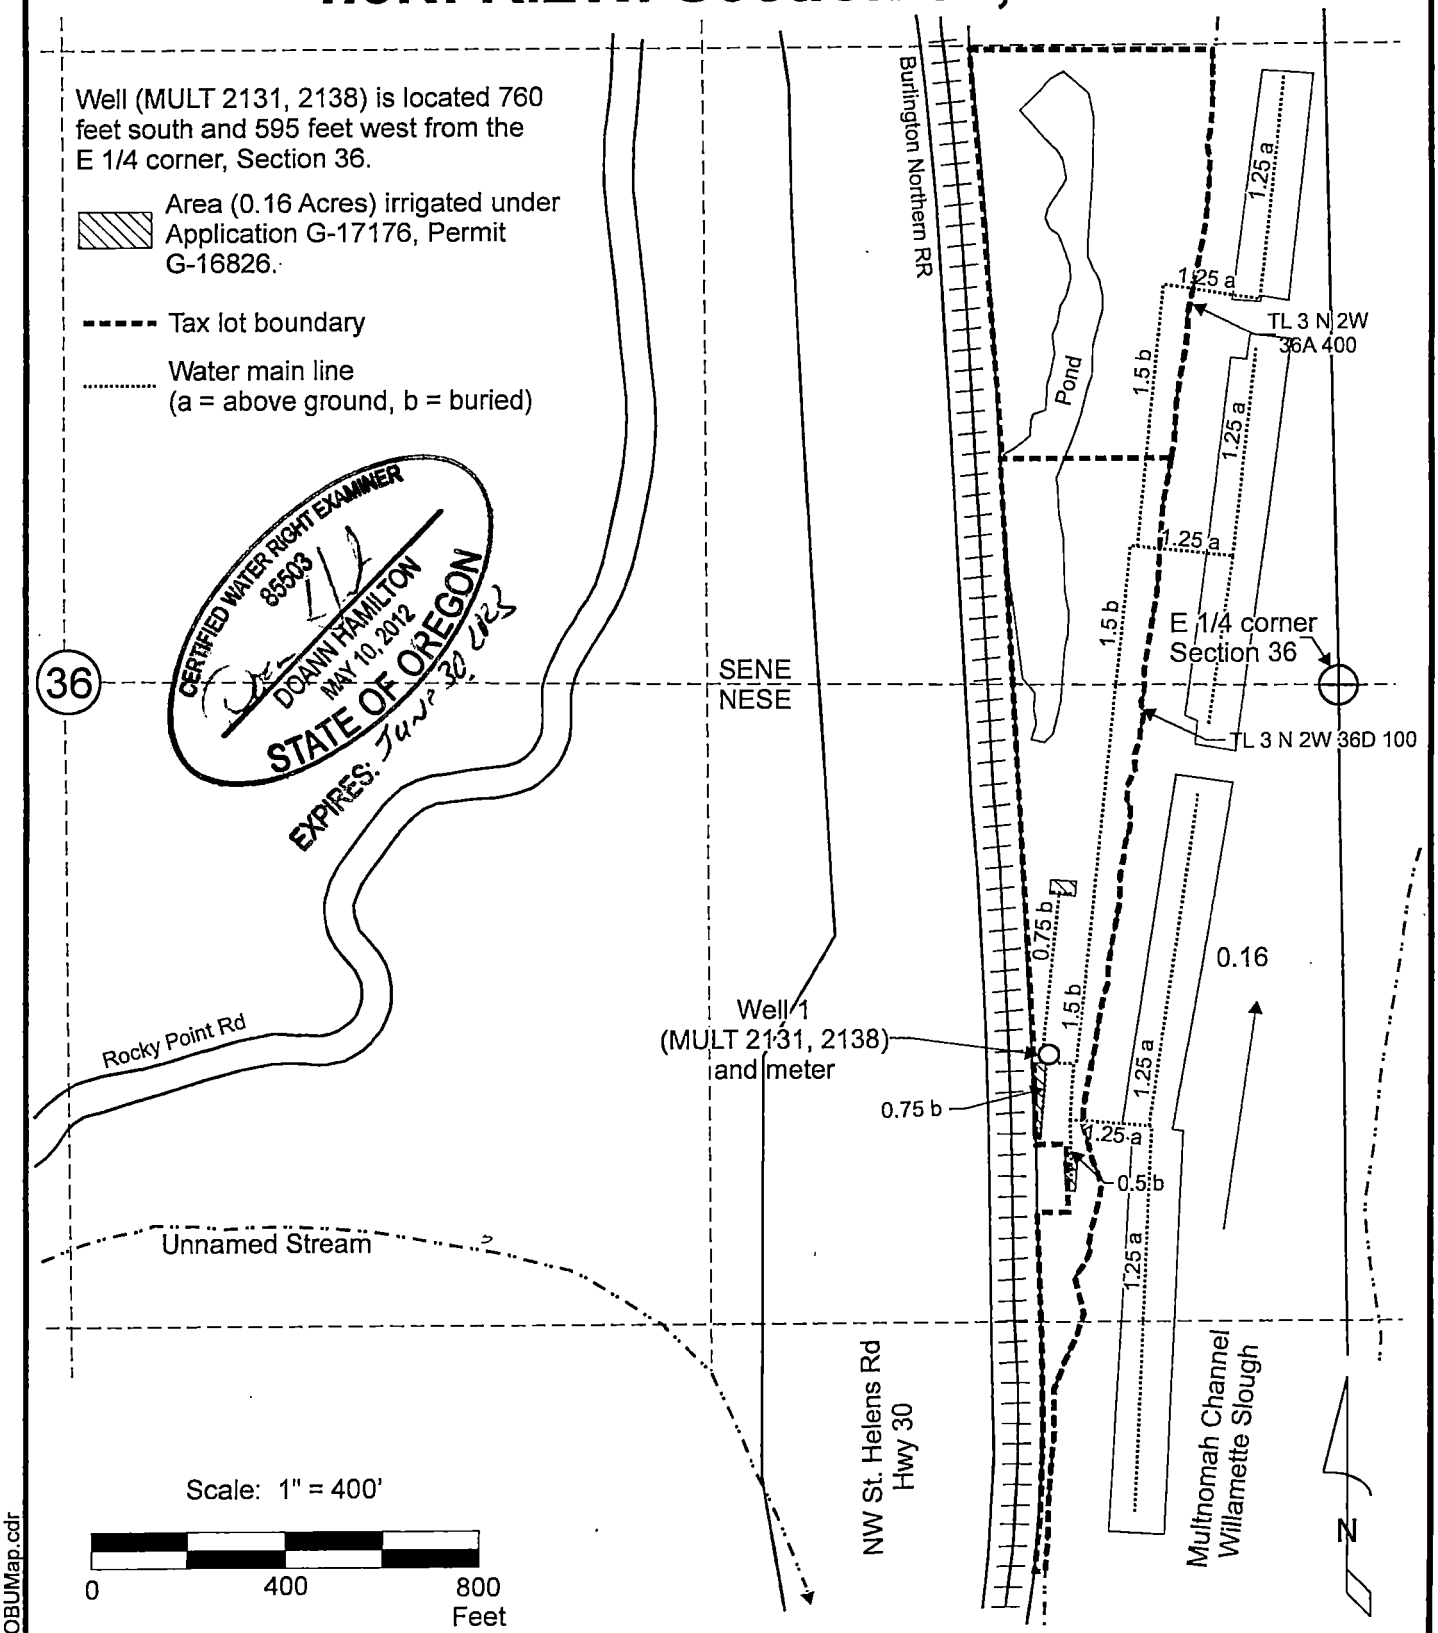

This map was prepared for the purpose of identifying the location of a water right only and is not intended to provide legal dimensions or location of property ownership lines.

TonnesonCOBUMap.cdr

Pacific Hydro-Geology Inc.

Claim of Beneficial Use Map
Application G-17176, Permit G-16826

Stan Tonneson LLC
T.3N. R.2W. Section 36, W.M.

07/2022