


- # 1 - 30 GAL. TANK
- # 2 - 500 GAL. TANK
- # 3 - 2, 2500 GAL. TANKS
- # 4 - LAUNDRAY ROOM

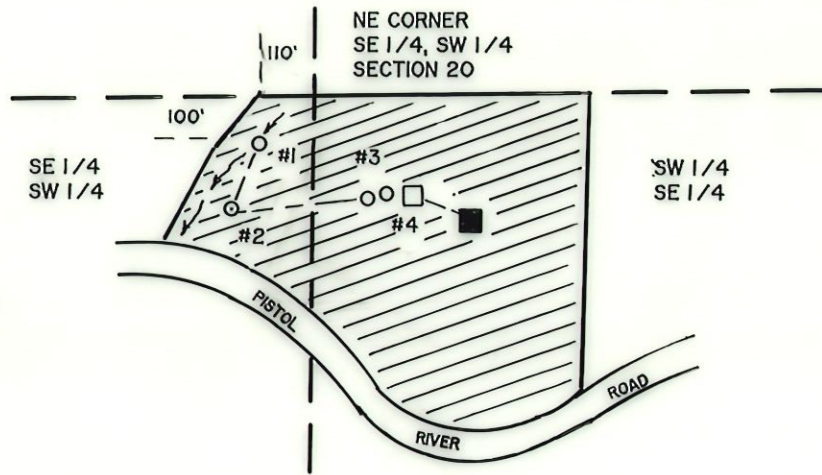

THE PREPARATION OF THIS MAP WAS FOR THE PURPOSE OF IDENTIFYING THE LOCATION OF THE PROPOSED WATER RIGHT AND HAS NO INTENT TO PROVIDE DEMENSIONS OR LOCATION OF PROPERTY LINES.



T 38 S, R 14 W, W.M., SECTION 20 FINAL PROOF SURVEY

UNDER

APPLICATION #S-71117 PERMIT # 52256

IN THE NAME OF

JAMES AND PATRICIA WALKER

SURVEYED DECEMBER 15, 1998 BY H.J. NEWHOUSE

SCALE 1" = 400'

RECEIVED

DEC 31 1998

WATER RESOURCES DEPT.
SALEM, OREGON

