

AMENDED

HANLEY ENGINEERING, INC.

P.O. BOX 701, 2043 MAIN STREET, BAKER CITY, OREGON 97814 (541) 523-3803

E-RECEIVED
JUNE 29 2026
OWRD

Q-15777 & T-10961


Sections 32, 33, 34 & 35,

Township 10 South, Range 42 East W.M., Lots 3 & 4

Section 2, Township 11 South, Range 42 East, W.M.


POD LOCATIONS

POD (TROY #1): 720 FEET SOUTH AND 2487 FEET WEST FROM THE NORTHEAST CORNER OF SECTION 32
WELL: 172 FEET NORTH AND 1725 FEET EAST FROM THE NORTHWEST CORNER OF SECTION 33
POD (TROY #2): 1586 FEET SOUTH AND 1905 FEET EAST FROM THE NORTHWEST CORNER OF SECTION 33
METER: 2030 FEET SOUTH AND 2308 FEET EAST FROM THE NORTHWEST CORNER OF SECTION 33
WENDT POD #1: 689 FEET SOUTH AND 203 FEET WEST FROM THE EAST QUARTER CORNER OF SECTION 33
WENDT POD #2: 1285 FEET SOUTH AND 639 FEET EAST FROM THE WEST QUARTER CORNER OF SECTION 34
WENDT POD #3: 2153 FEET SOUTH AND 2130 FEET EAST FROM THE WEST QUARTER CORNER OF SECTION 34
BRISKEY POD #1: 2123 FEET SOUTH AND 3339 FEET EAST FROM THE WEST QUARTER CORNER OF SECTION 34
BRISKEY POD #2: 1951 FEET SOUTH AND 3800 FEET EAST FROM THE WEST QUARTER CORNER OF SECTION 34

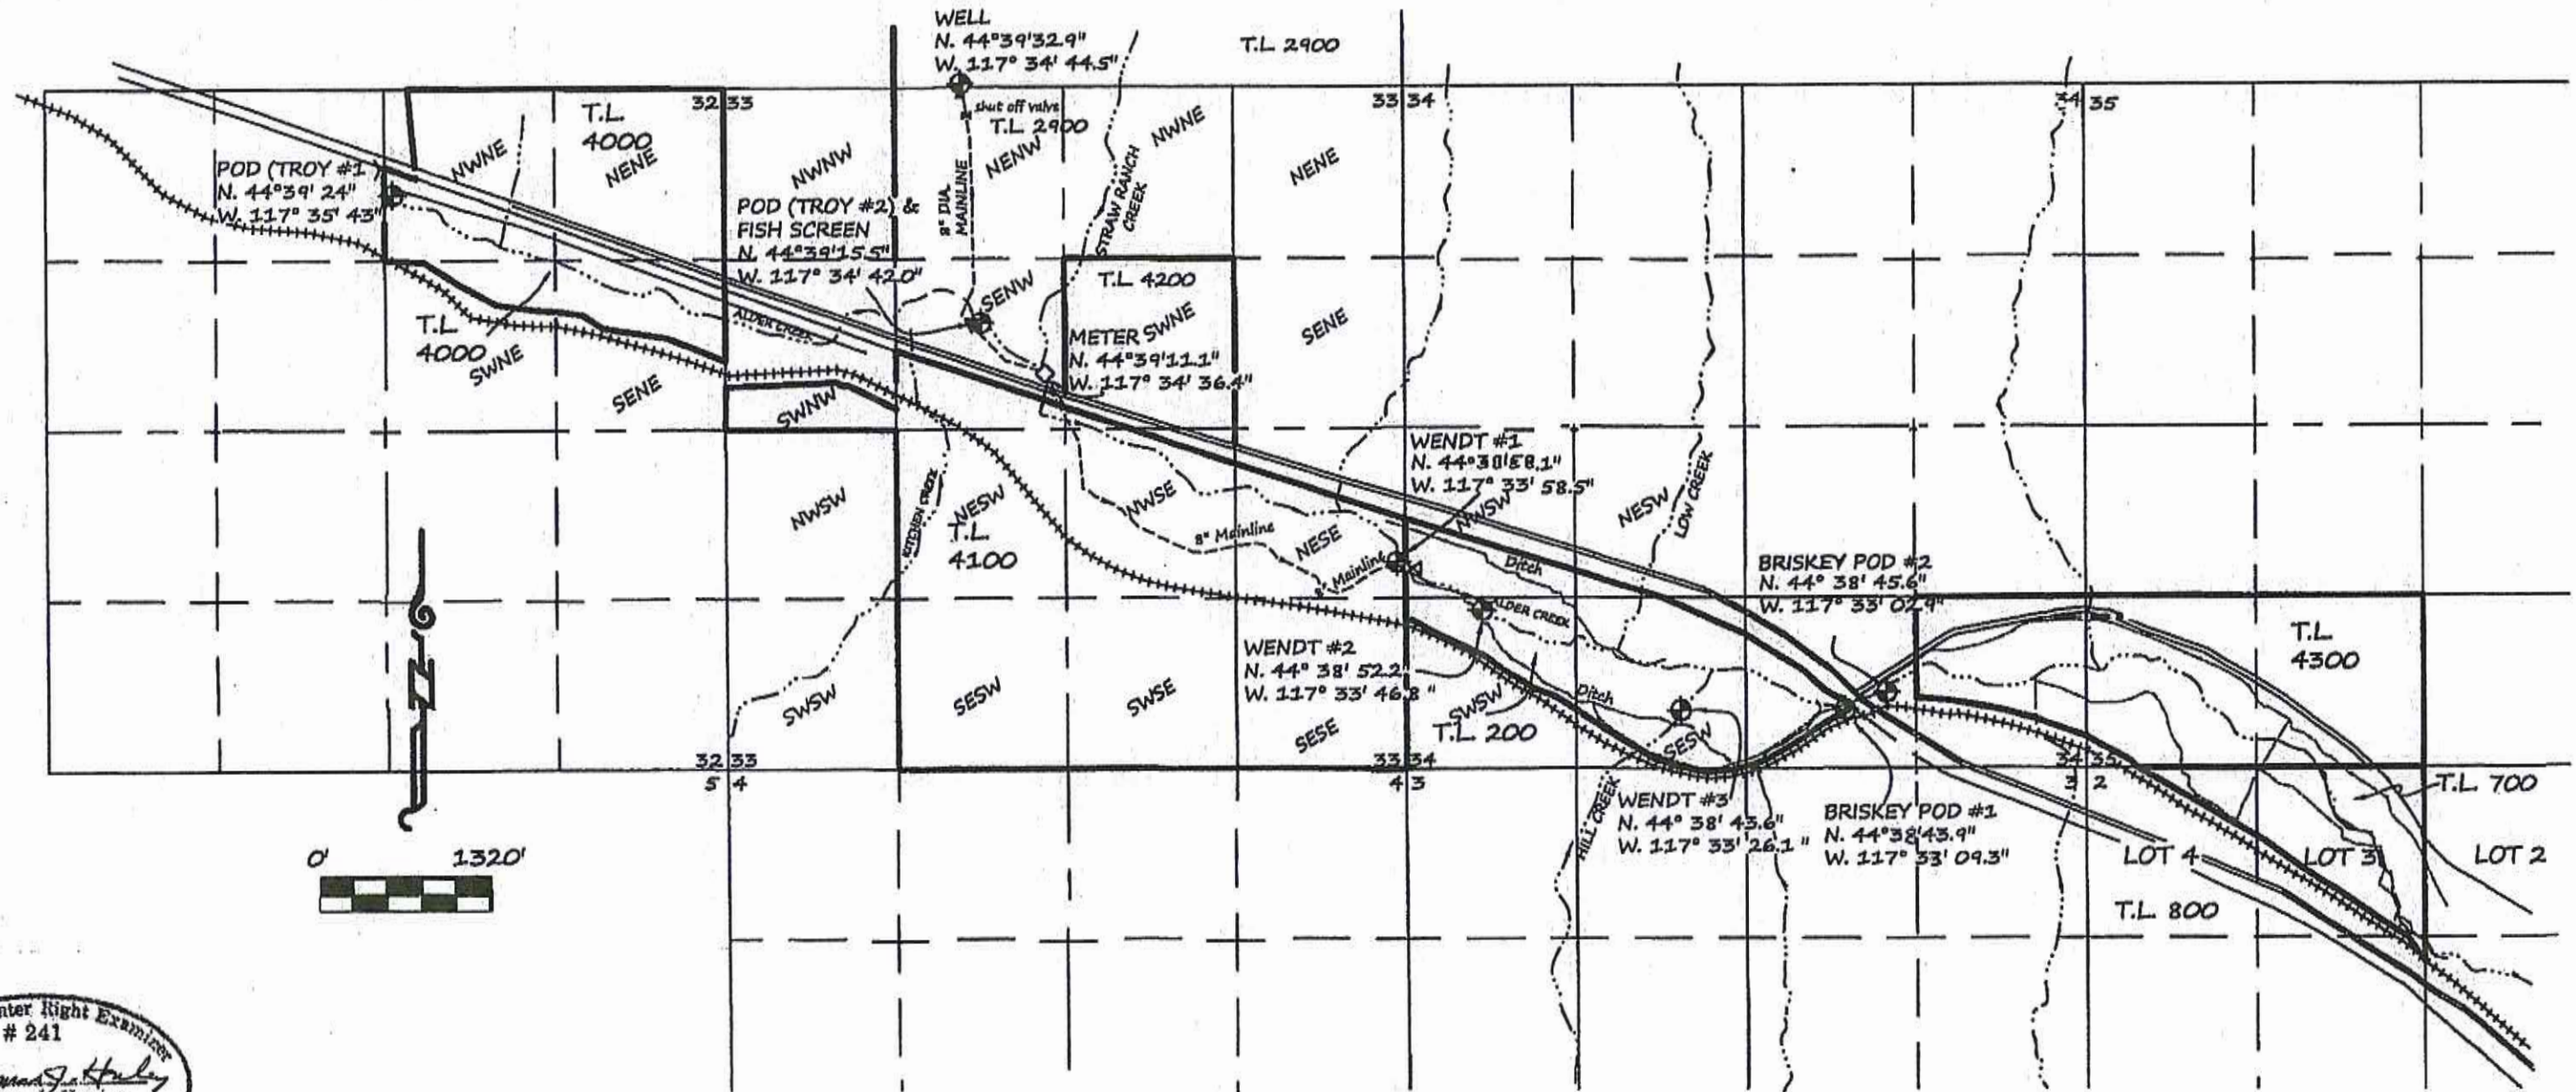

POINTS OF DIVERSION AND DELIVERY SYSTEM

THIS MAP IS FOR THE PURPOSE OF LOCATION OF A WATER RIGHT ONLY AND HAS NO INTENT TO PROVIDE LEGAL DIMENSIONS OR THE LOCATION OF PROPERTY LINES.

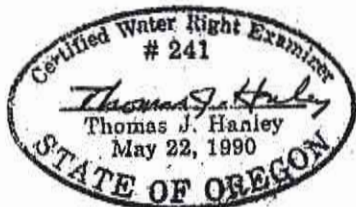

EDITED JUNE, 2026

COBU MAP # 1198 A-7

4


HANLEY ENGINEERING, INC.

P.O. BOX 701, 2043 MAIN STREET, BAKER CITY, OREGON 97814 (541) 523-3803

Transfer 10961

Certificate No. 6005

Sections 32, 33, 34 & 35,
Township 10 South, Range 42 East W.M.,

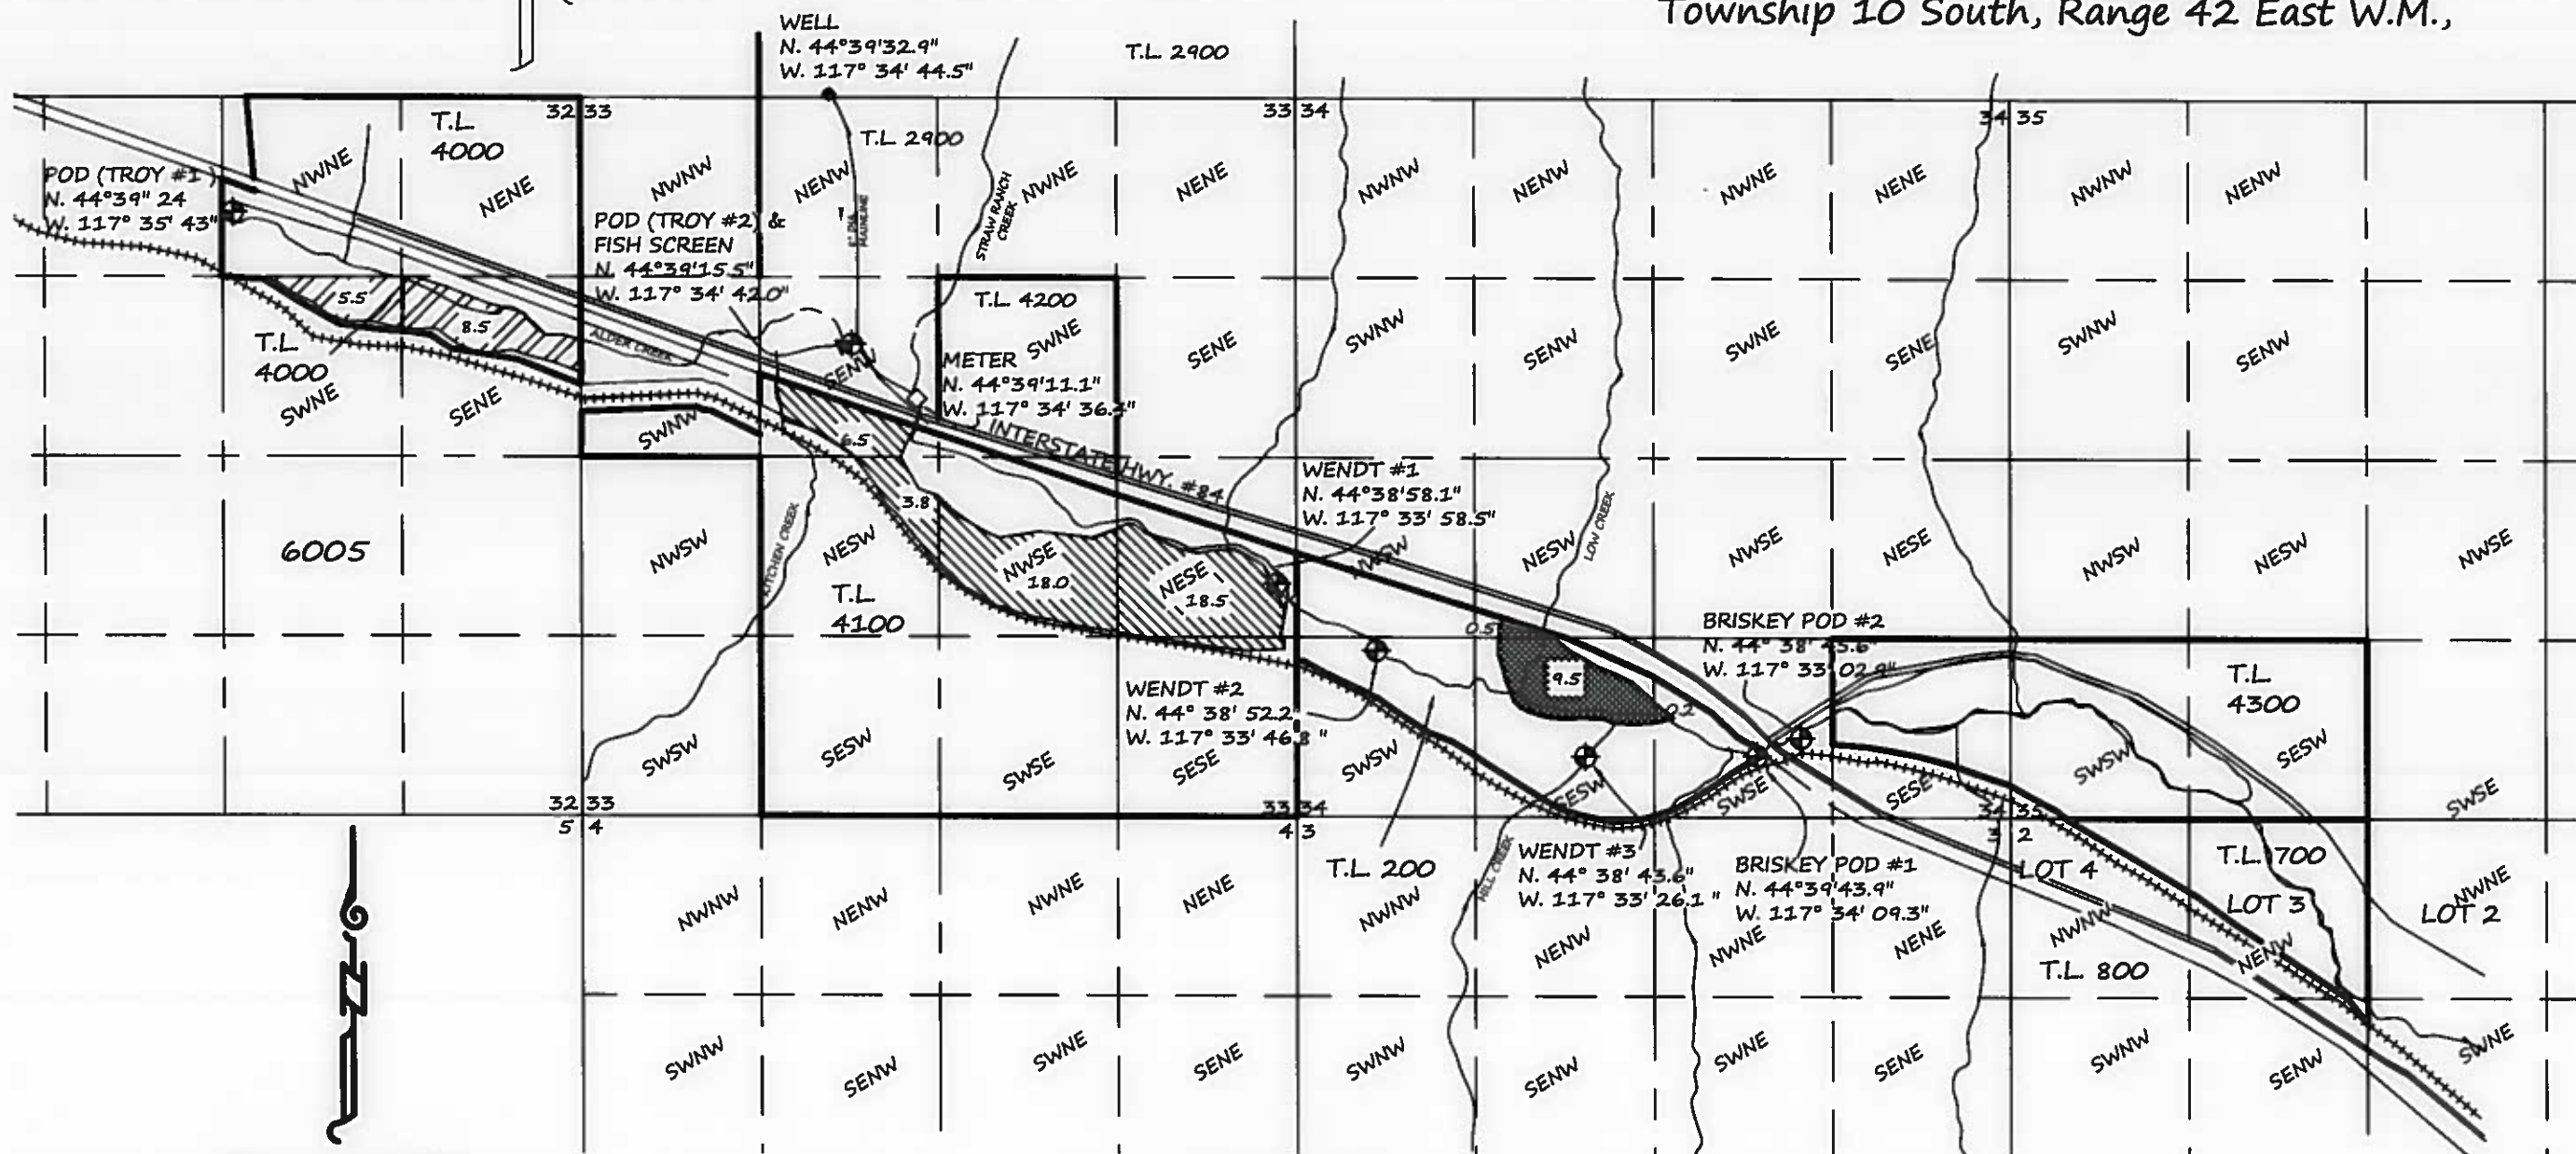

THIS MAP IS FOR THE PURPOSE OF LOCATION OF
A WATER RIGHT ONLY AND HAS NO INTENT TO
PROVIDE LEGAL DIMENSIONS OR THE LOCATION
OF PROPERTY LINES.

LEGEND

- Points of Diversion
- Place of Use C-6005 1877 Alder Cr Troy # 2
- Place of Use C-6005 1877 Alder Cr. Wendt #3
- Place of Use C-6005 1909 Alder Cr. Troy #1

