

Amended

HANLEY ENGINEERING, INC.

P.O. BOX 701, 2043 MAIN STREET, BAKER CITY, OREGON 97814 (541) 523-3803

E-RECEIVED
JUNE 29 2026
OWRD

Q-15777 & T-10961


Sections 32, 33, 34 & 35,

Township 10 South, Range 42 East W.M., Lots 3 & 4

Section 2, Township 11 South, Range 42 East, W.M.


POD LOCATIONS

POD (TROY #1): 720 FEET SOUTH AND 2487 FEET WEST FROM THE NORTHEAST CORNER OF SECTION 32
WELL: 172 FEET NORTH AND 1725 FEET EAST FROM THE NORTHWEST CORNER OF SECTION 33
POD (TROY #2): 1586 FEET SOUTH AND 1905 FEET EAST FROM THE NORTHWEST CORNER OF SECTION 33
METER: 2030 FEET SOUTH AND 2308 FEET EAST FROM THE NORTHWEST CORNER OF SECTION 33
WENDT POD #1: 689 FEET SOUTH AND 203 FEET WEST FROM THE EAST QUARTER CORNER OF SECTION 33
WENDT POD #2: 1285 FEET SOUTH AND 639 FEET EAST FROM THE WEST QUARTER CORNER OF SECTION 34
WENDT POD #3: 2153 FEET SOUTH AND 2130 FEET EAST FROM THE WEST QUARTER CORNER OF SECTION 34
BRISKEY POD #1: 2123 FEET SOUTH AND 3339 FEET EAST FROM THE WEST QUARTER CORNER OF SECTION 34
BRISKEY POD #2: 1951 FEET SOUTH AND 3800 FEET EAST FROM THE WEST QUARTER CORNER OF SECTION 34

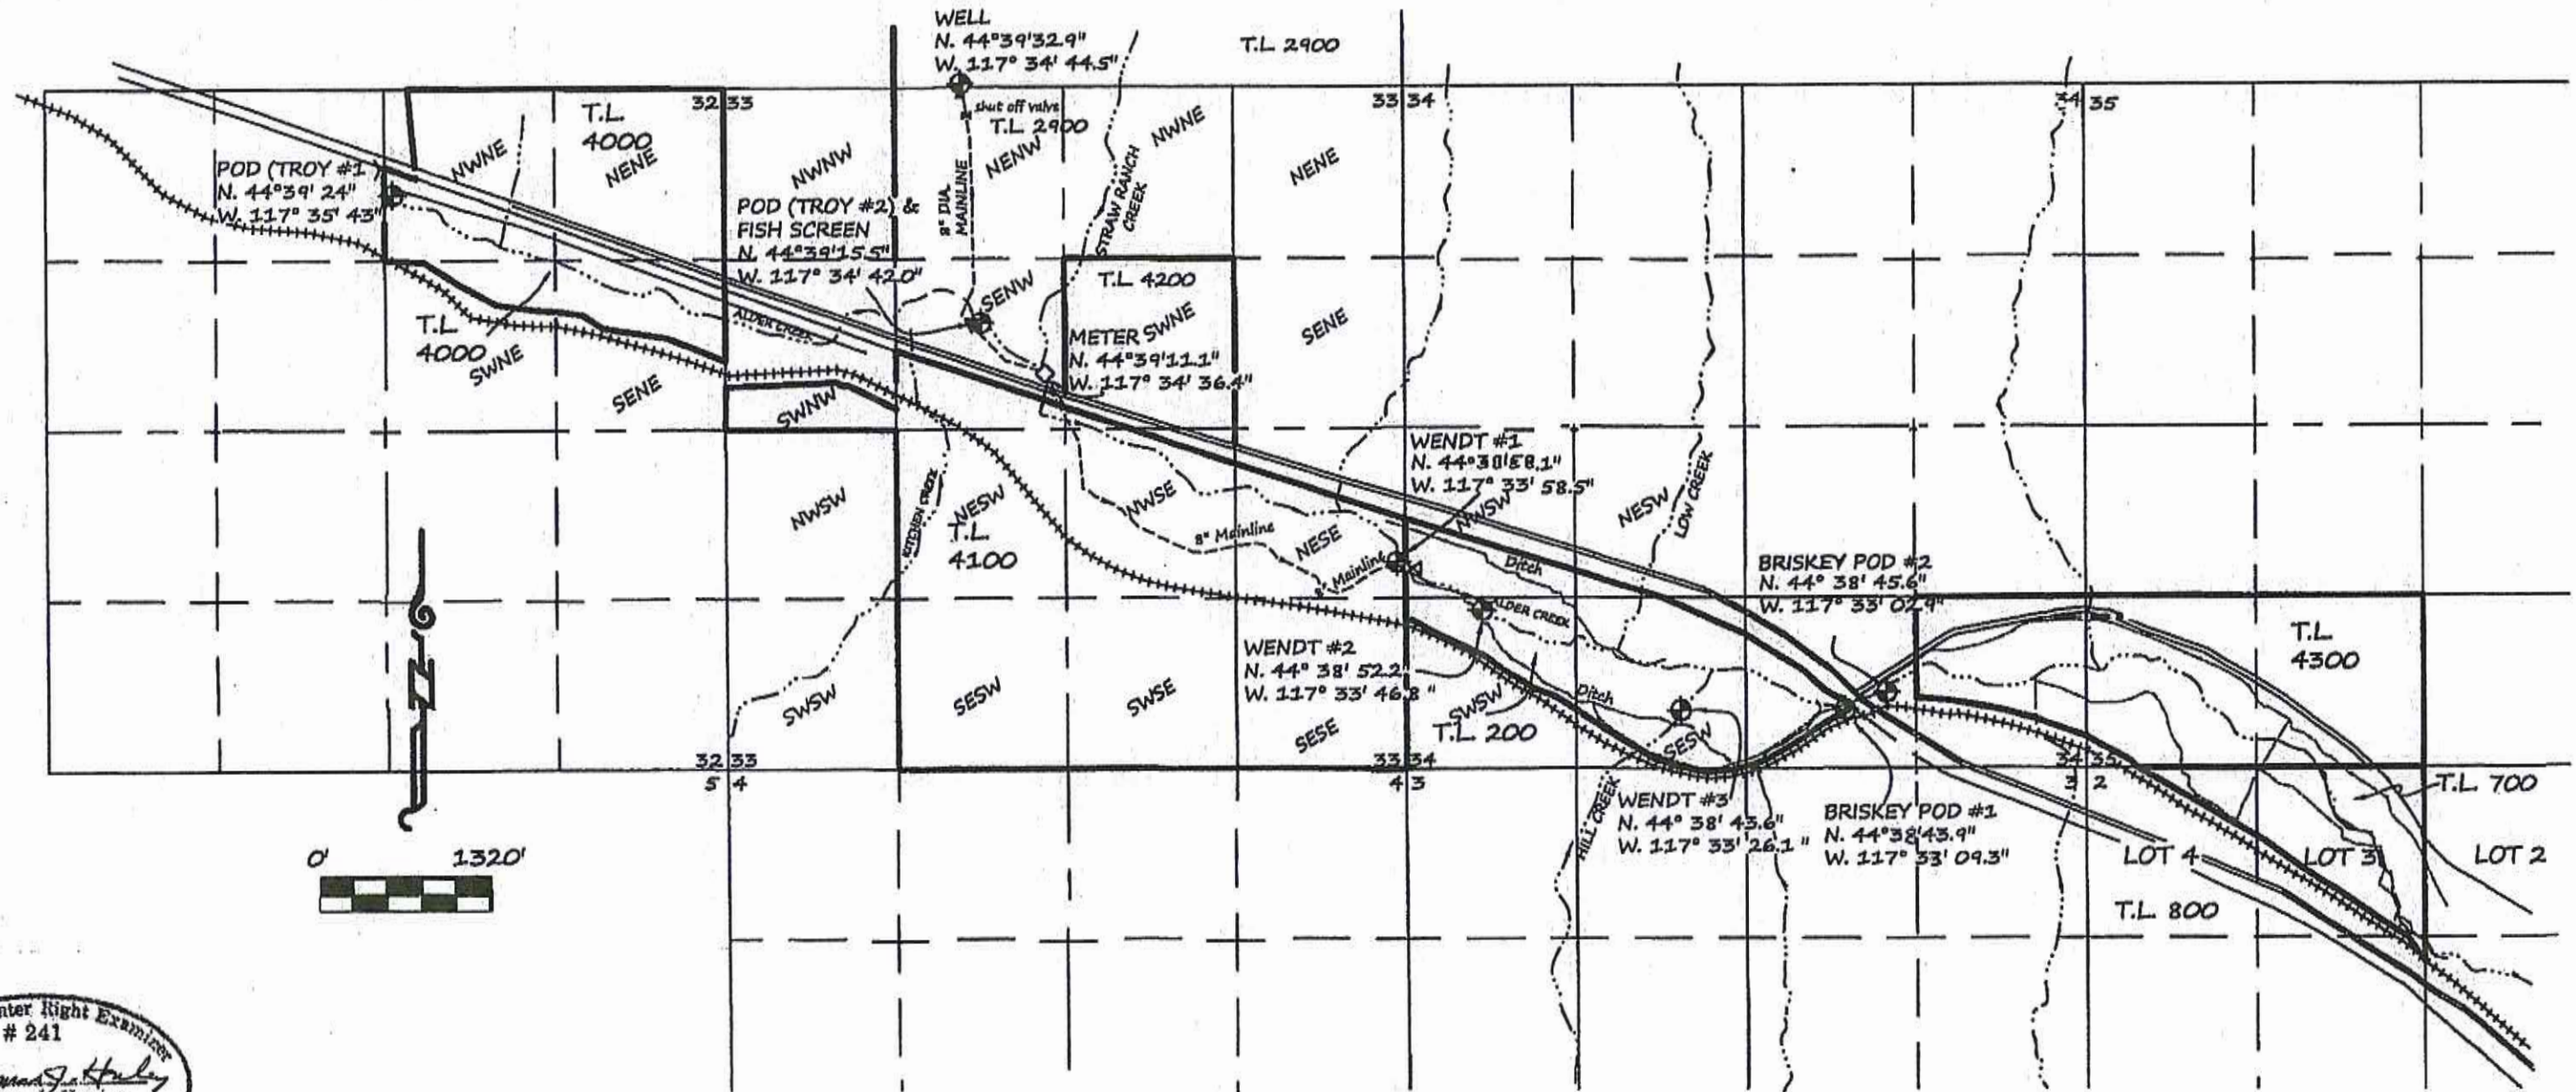

POINTS OF DIVERSION AND DELIVERY SYSTEM

THIS MAP IS FOR THE PURPOSE OF LOCATION OF A WATER RIGHT ONLY AND HAS NO INTENT TO PROVIDE LEGAL DIMENSIONS OR THE LOCATION OF PROPERTY LINES.

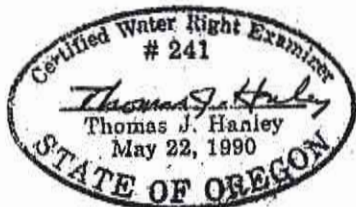

EDITED JUNE, 2026

RECEIVED

SEP 30 2019


OWRD

HANLEY ENGINEERING, INC.

P.O. BOX 701, 2043 MAIN STREET, BAKER CITY, OREGON 97814 (541) 523-3803

PLACE OF USE FOR PERMIT G-15774 (T-10961)


Sections 33, 34, 35, T. 10 S., R. 42 E., W.M.
Lots 2, 3, 4 Section 2, T. 11 S., R. 42 E., W.M.
Supplemental Right

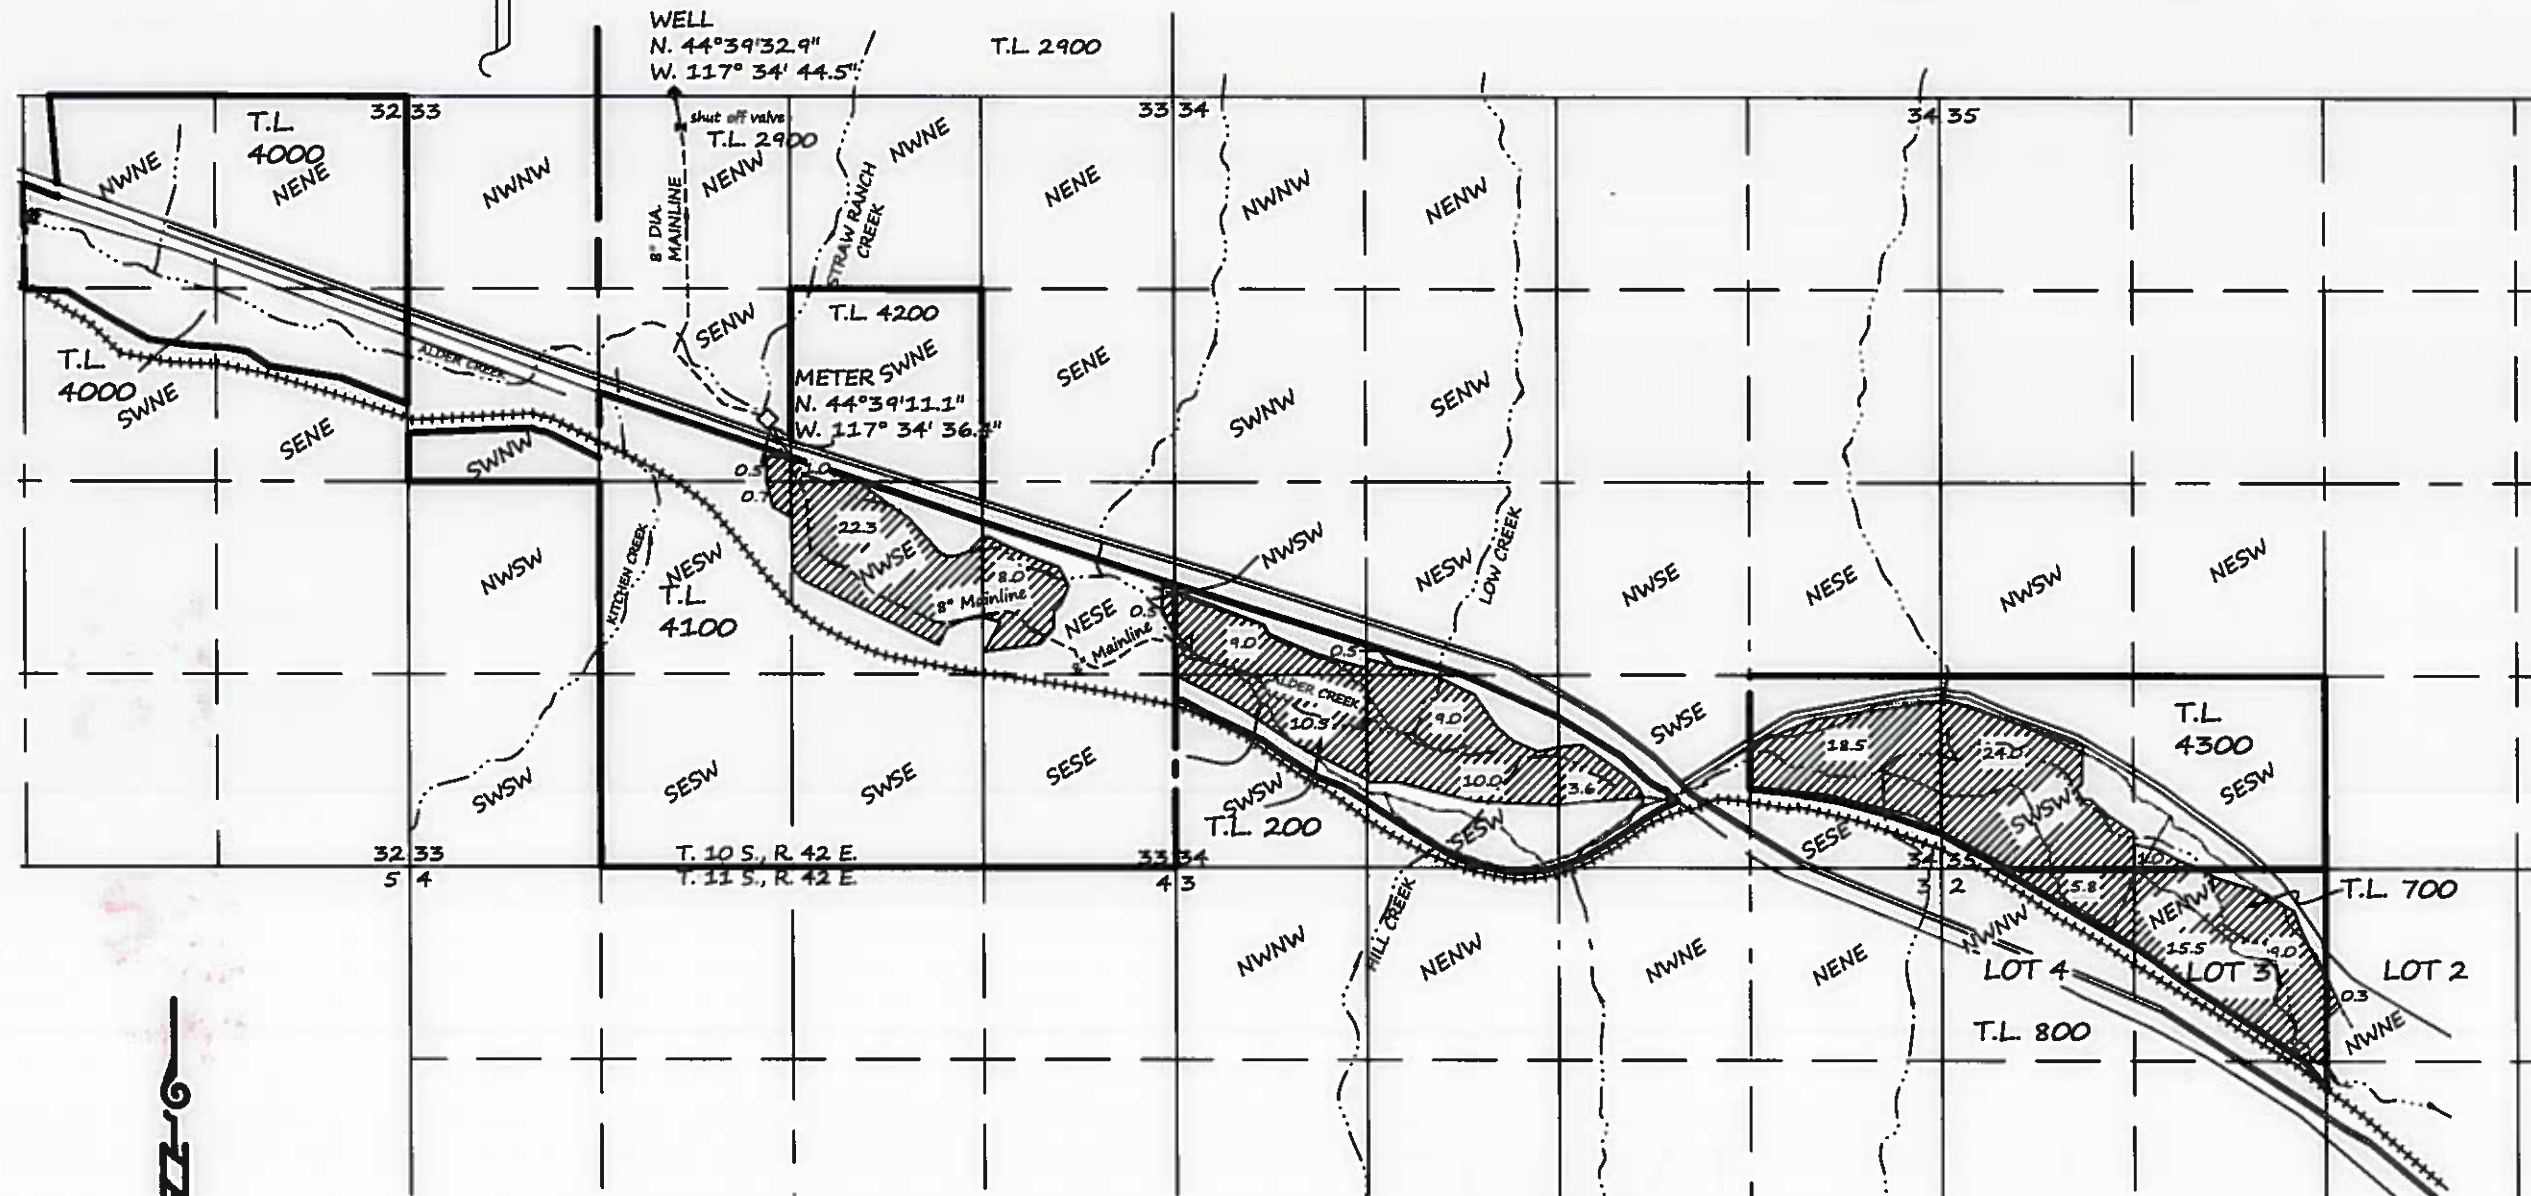

COBU MAP # 1198 A-7 ①

LEGEND

- Point of Appropriation (Well)
- ◇ Meter
- ⋈ Valve
- ▨ Place of Use for G-15774

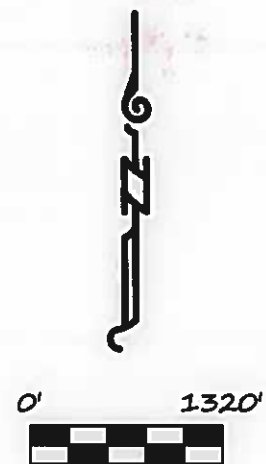

THIS MAP IS FOR THE PURPOSE OF LOCATION
OF A WATER RIGHT ONLY AND HAS NO INTENT
TO PROVIDE LEGAL DIMENSIONS OR THE
LOCATION OF PROPERTY LINES.

