

POA (Well-1)

Conveyance

Cert. 81319 "From" Lands

Amended COBU "To" Lands

Unchanged (Cert. 96206 RR)

Taxlot 0200 Boundary

CERTIFIED WATER RIGHT EXAMINER

104303

IAN A. GODWIN


JULY 07, 2024

STATE OF OREGON

EXPIRES: 06/30/27

All "To" Lands are within Taxlot 0200.

Sec 21 NESW: 0.3 ac
 Sec 21 SESW: 1.3 ac
 Sec 21 NWSE: 27.2 ac
 Sec 21 SWSE: 34.6 ac
 Sec 21 SESE: 6.8 ac
 Sec 28 NWNE: 1.2 ac

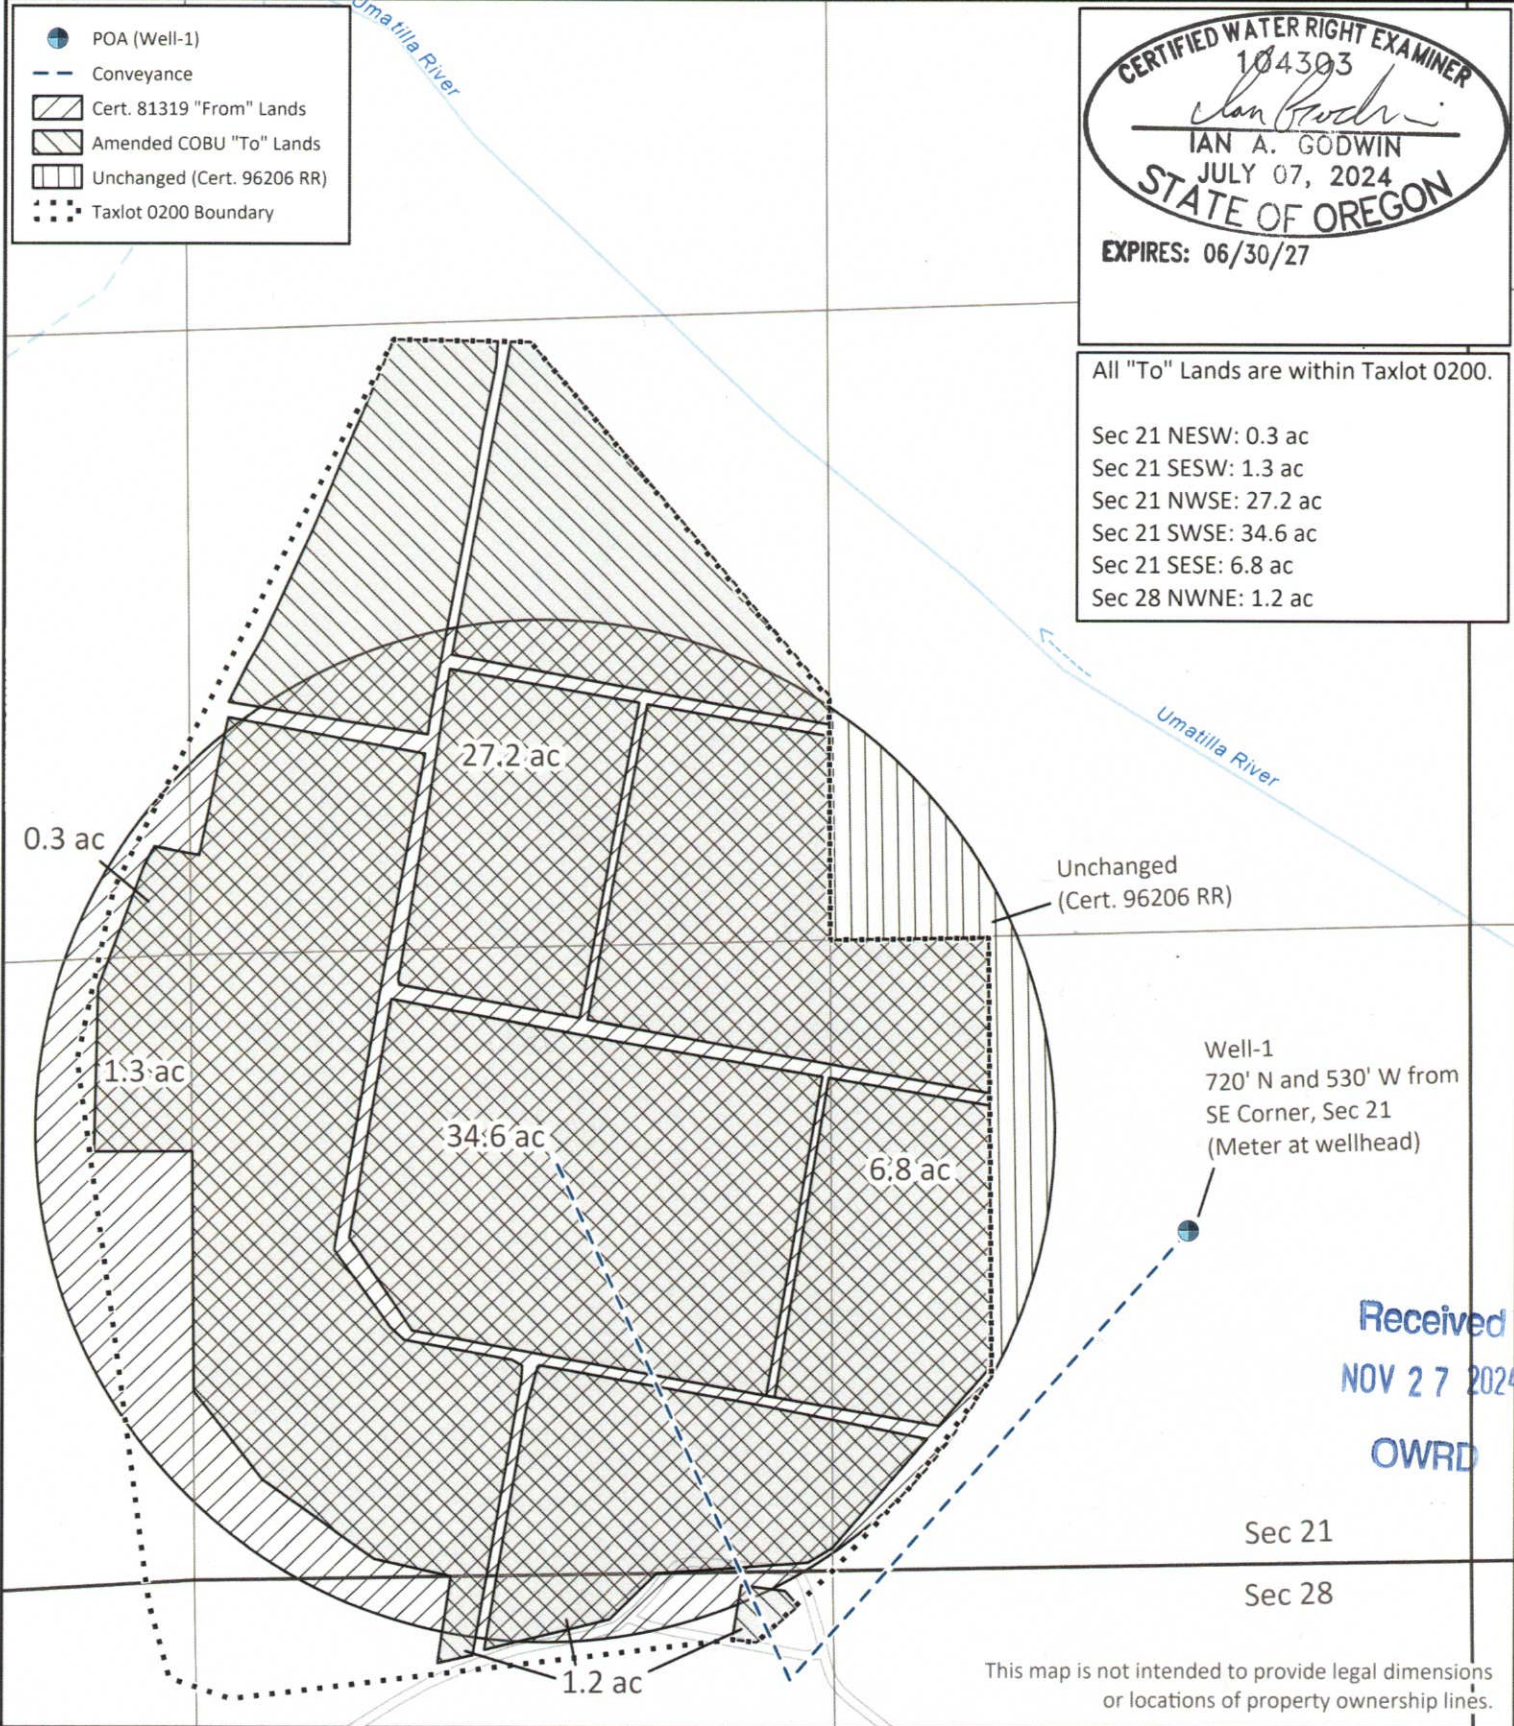

This map is not intended to provide legal dimensions or locations of property ownership lines.

CWM-H2O

Complete Water Management

311 B Avenue, Suite P

Lake Oswego, Oregon 97034

(503) 954-1326

Attachment 1

Amended Claim of Beneficial Use Map

Transfer T-13830 (T3N, R29E, Sec 21 and 28)

1	DATE	AUTH	DRAFT
No.	Date	By	Revisions

N

0

150

300

600 ft

1 : 4,800

Proj#: 2314001


Transfer T-13830 COBU

New Foothills Properties

75049 Snow Road

Echo, OR 97826

CERTIFIED COPY RIGHTS EXAMINER
 101100 WATE
 TRAVIS
 STATE REG
 EXPIRES 6/30/24

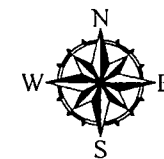

GEOENGINEERS 