


T22 S, R 31 E, WM

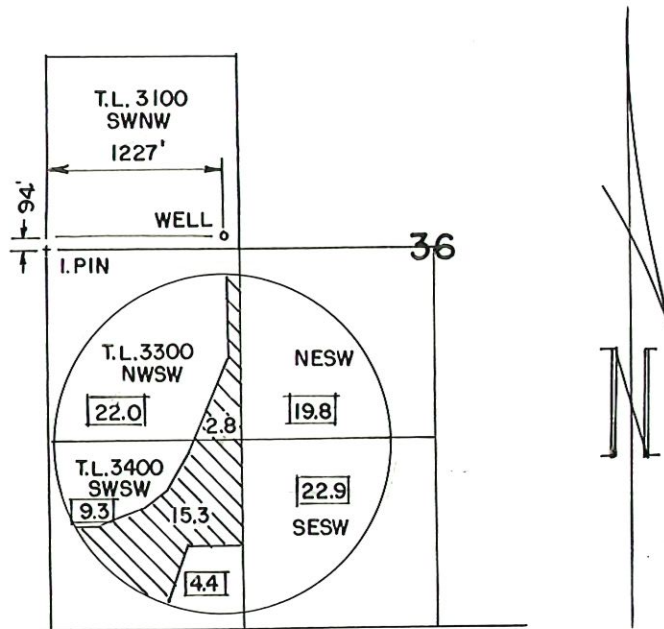

THE PURPOSE OF THIS MAP IS TO IDENTIFY THE LOCATION OF THE WATER RIGHT. IT IS NOT INTENDED TO PROVIDE INFORMATION RELATIVE TO THE LOCATION OF PROPERTY OWNERSHIP.

RECEIVED


NOV 19 2003

WATER RESOURCES DEPT
SALEM, OREGON

THIS MAP IS THE POU CHANGE ONLY; SEE ADD'T MAP
OWRD/CNH 7.17.2026

	FINAL PROOF SURVEY		
	UNDER T-9208		IN THE NAME OF JACK YOUNG
	Scale: 4" = 1 MILE	Date: NOV. 2003	Job: 1966-02A
	Dsn:		Sht. No.
Drn: CHRIS	of 1		
Ckd:	M.A. PALMER & SONS, INC. ENGINEERING & SURVEYING 711 Ponderosa Village • Box 61 Burns, Oregon 97720		

T. 22 S., R. 31 E., W. M.

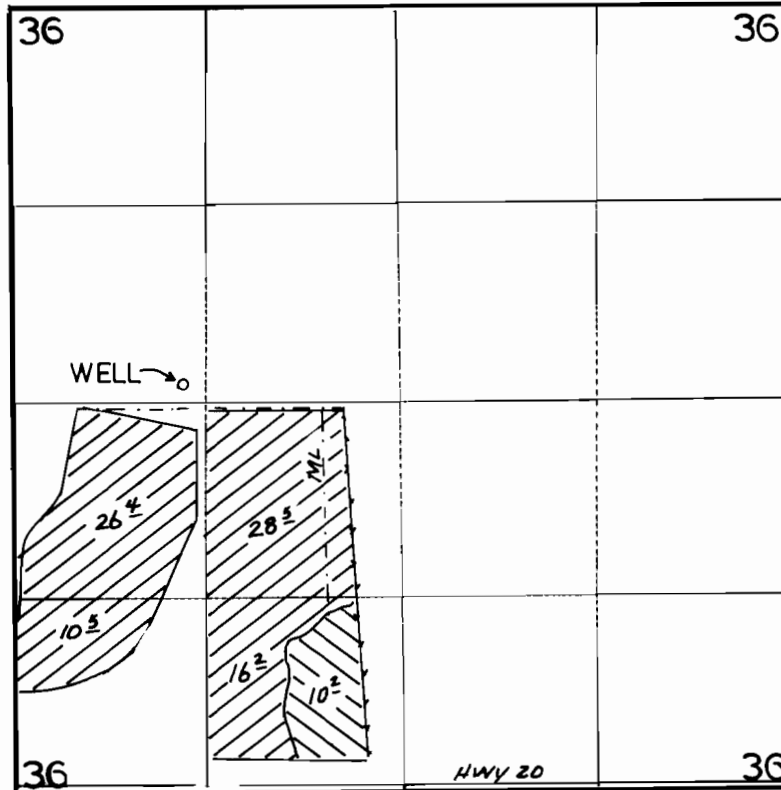

1" = 1320'

WELL - 110' N. & 115' E. FROM THE W 1/4 COR., SEC. 36.



PRIMARY



suppl to Prather Creek
1884 Decreed Right V. P50.

USE FOR WELL LOCATIONS AND
ORIGINAL 6.6 ACRES IN SE SW THAT
CHANGE USE ONLY
[OWRD/CNH 7.17.2026]

FINAL PROOF SURVEY UNDER

Application No. G-10604. Permit No. G-9900.....
IN NAME OF

Jack and Merilee Young

Surveyed 5-13-1997, by J. MILLER.....
3-2-2000

RECEIVED

APR 30 2001

WATER RESOURCES DEPT
SALEM, OREGON

41025-279-172C

RECEIVED 10/10/92 SK