


CLAIM OF BENEFICIAL USE MAP

TO CHANGE PLACE OF USE AND ADD A POINT OF APPROPRIATION
PER APPLICATION T-14017

TAX LOT: 1700 IN SECTION 28,
TOWNSHIP 22 SOUTH, RANGE 32 EAST, W.M.

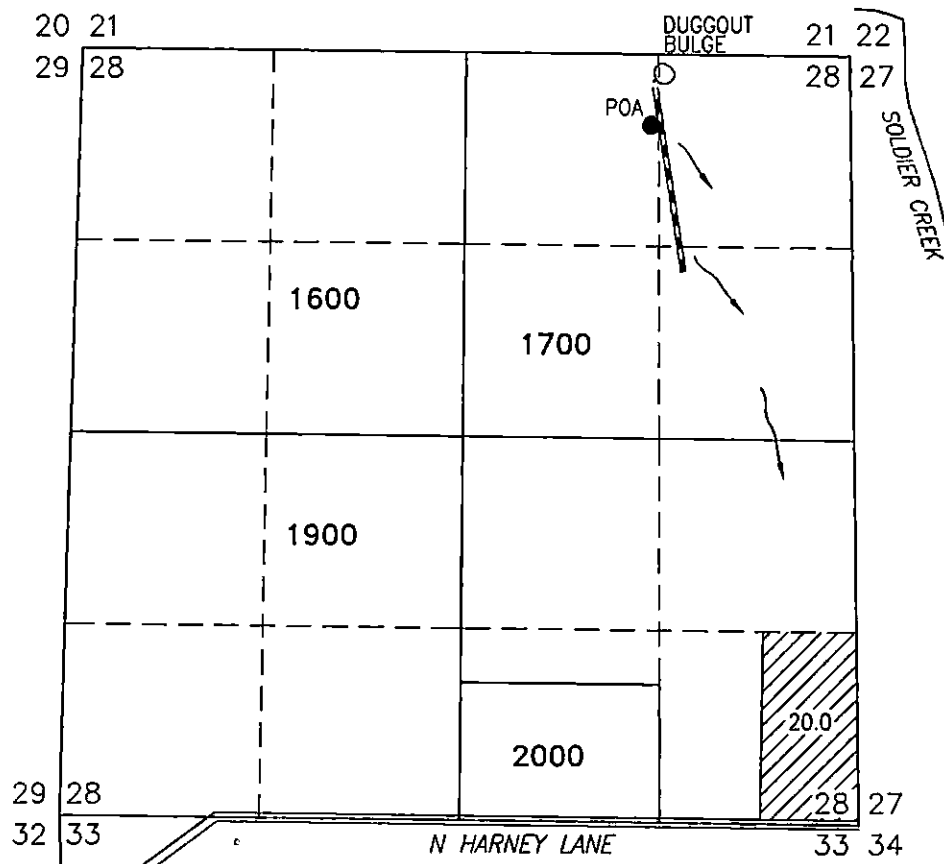

SHEET FLOW DIRECTION

BURIED 6" MAINLINE


POA (HARN 50944/50952)

- LOCATED IN THE NW 1/4 NE 1/4 SECTION 28, T22S R32E, W.M. AND 485 FEET SOUTH AND 1369 FEET WEST FROM THE NE CORNER OF SECTION 28. METER IS LOCATED 4 FEET EAST FROM WELL.



20.0 ACRES IR FROM T-14017 AND POA,
AS SHOWN

THIS MAP IS FOR THE PURPOSE OF LOCATING A WATER RIGHT ONLY AND HAS NO INTENT TO PROVIDE LEGAL DIMENSIONS OR THE LOCATION OF PROPERTY LINES.

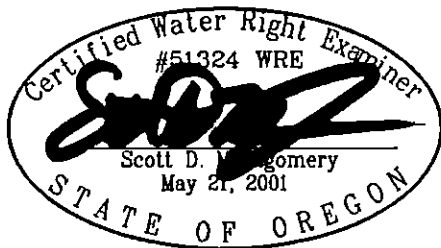

RENEWAL DATE: 12/31/2026

PREPARED FOR:

JOSEPH & VIVIAN CRONIN
35049 N HARNEY LANE
BURNS, OR 97720

PREPARED BY:



ALL POINTS ENGINEERING AND SURVEYING, INC.
P.O. BOX 767 TERREBONNE, OR 97760
(541) 548-5833 www.APEandS.com