


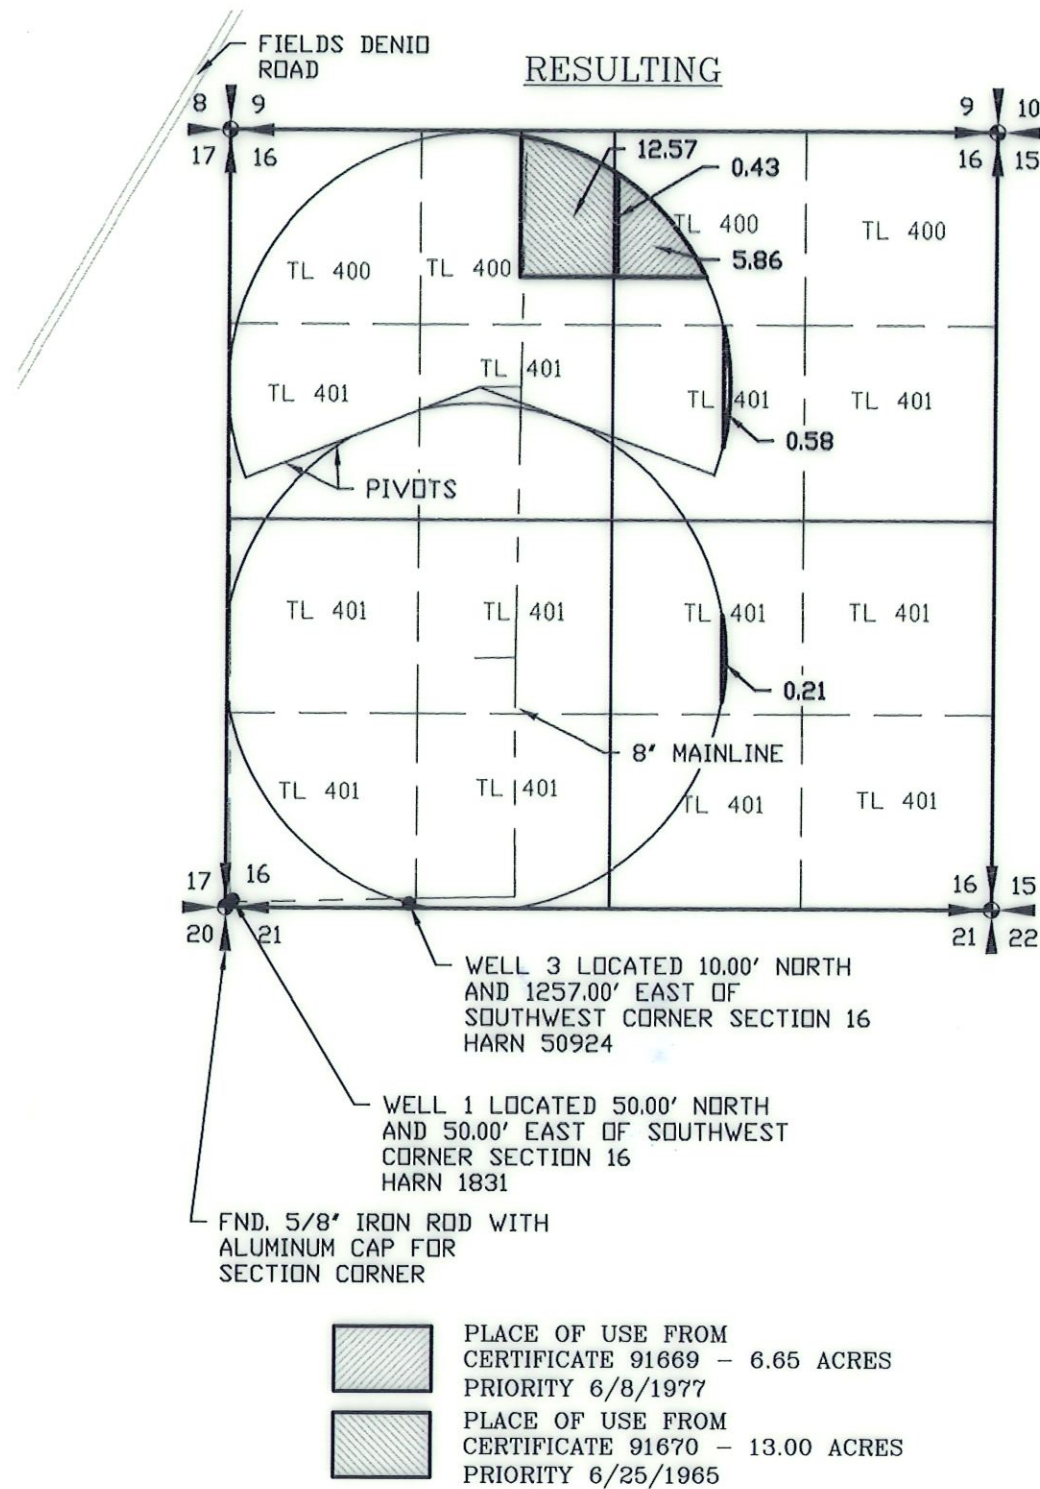

CLAIM OF BENEFICIAL USE MAP

FOR
**GARRICK & KATHERINE
WAALKES**

SECTION 16, T41S R35E W.M.
HARNEY COUNTY, OREGON


LEGEND

- SECTION LINE
- 1/4 SECTION LINE
- 1/16 SECTION LINE
- MAIN LINE

TRANSFER NO. T-14356



SCALE: 1"=1320'

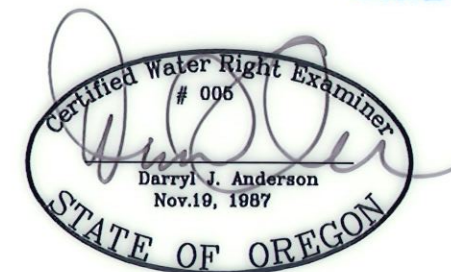

RENEWAL 12/31/25

NOTE:
PREPARATION OF THIS MAP IS FOR IDENTIFYING WATER RIGHTS ONLY. IT
HAS NO INTENT TO PROVIDE LOCATIONS OR DIMENSIONS OF PROPERTY
BOUNDARIES.

REVISION	BY

**ANDERSON ENGINEERING
AND SURVEYING, INC.**
P.O. BOX 28
LAKEVIEW, OREGON 97630
(541) 947-4407/FAX: 947-2321
WWW.ANDERSONENGINEERING.COM

FOR:
KATHERINE WAALKES
13549 FIELDS DENIO RD
FIELDS, OR 97710
503-550-4799

CLAIM OF BENEFICIAL USE MAP
TRANSFER NO. T-14356
SEC. 16, T41S, R35E W.M.

DATE:	9/25/2023
SCALE:	1" = 1320'
DWG. BY:	R.C.
JOB:	2023-026
FILE:	2023-026
SHEET:	1 OF 1