

FINAL PROOF SURVEY


SITUATED IN THE E1/2 OF SECTION 11, THE W1/2 E1/2 AND
THE W1/2 OF SECTION 12, AND THE NW1/4 OF
SECTION 13, T40S, R9EWM, KLAMATH COUNTY,
MAY, 2011

MAP PREPARED FOR

--BALIN RANCH--



SCALE
1" = 1320'

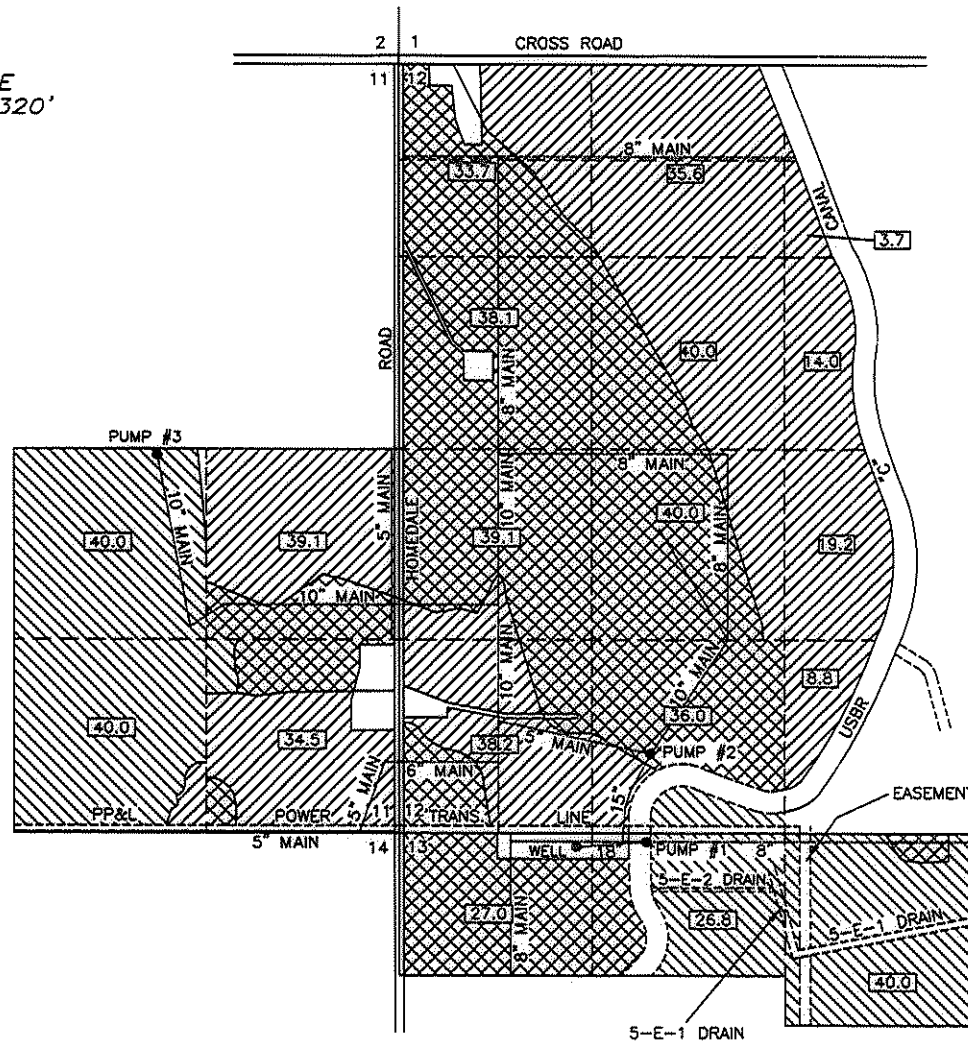

NOTES:

1. MAP PREPARED FROM: ASSESSORS MAP AND AERIAL PHOTOGRAPH.
2. WELL IS 1212 FEET EAST AND 93 FEET SOUTH OF THE NORTHEAST CORNER OF SECTION 13.
3. PUMP #1 IS 1689 FEET EAST AND 58 FEET SOUTH OF THE NORTHEAST CORNER OF SECTION 13.
4. PUMP #2 IS 1719 FEET EAST AND 541 FEET NORTH OF THE NORTHEAST CORNER OF SECTION 13.
5. PUMP #3 IS 1655 FEET WEST AND 2675 FEET NORTH OF THE NORTHEAST CORNER OF SECTION 13.
6. TOTAL AREA THIS APPLICATION: 593.8 ACRES
7. APPLICATION # G-15679
8. PERMIT # G-15333
9. TAX LOT #'S: R-4009-01200-400, 401, 402, 500, 600, 1100, 1200, 1300, 1400, R-4009-01100-00600-000 AND R-4009-01300-00200-000.
10. AREAS NOT HATCHED ARE "OUT".



LANDS SUPPLEMENTAL TO
KLAMATH BASIN IMPROVEMENT DISTRICT



LANDS SUPPLEMENTAL TO
WARREN ACT




LANDS SUPPLEMENTAL TO
KLAMATH IRRIGATION DISTRICT

XXX

ACREAGE PER 1/4 1/4 SECTION

THE PURPOSE OF THIS MAP IS TO IDENTIFY THE
LOCATION OF THE WATER RIGHT APPLICATION. IT IS
NOT INTENDED TO PROVIDE INFORMATION RELATIVE
TO THE LOCATION OF PROPERTY OWNERSHIP
BOUNDARY LINES.

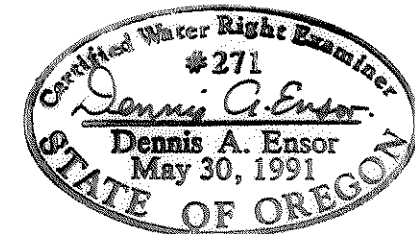

TRU SURVEYING INC. LINE

2333 SUMMERS LANE
KLAMATH FALLS, OREGON 97603